

Jan. 26, 1959

N.E. Corner Section 14, T30S  
R2W, N.1/4 as det. by O.B.T.

15" La. Stump bears  $S76\frac{1}{2}^{\circ}E$   
10.5' dist. O.B.T. fd. scribe

At corner point found large  
stone and set  $3\frac{1}{4}'' \times 40''$  I.R.  
from which

36" Pin bears  $S24^{\circ}E$  21.0' dist.  
mkd. 513 B.T.


5" Pin bears  $N33^{\circ}E$  9.3' dist.  
mkd. 511 B.T.

12" La. bears  $N11^{\circ}E$  10.0' dist.  
mkd. 511 B.T.

9" La. bears  $S72^{\circ}W$  64.0' dist.  
mkd. 514 T30S R2W B.T.

S.W. Cor. Sec. 12 bears East  $120.0'$

Witness: R. G. Boyd.

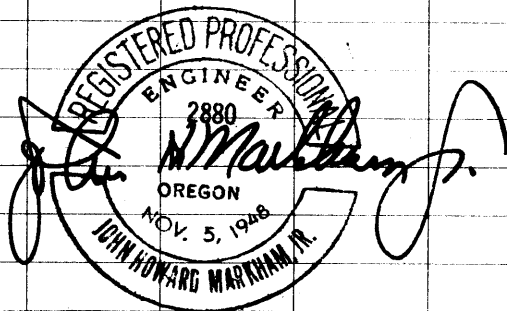

Work done for Storer Lbr Co  
C.S. File No. 42/421-5