

Feb. 23, 1960


$\frac{1}{16}$ corner Sec. 11 C.W. T30S
R2W W.M.

At corner pt. set $\frac{3}{4} \times 30$ " I.P.
from which

13" Fir bears N41E 30.6'
dist. mkd. $\frac{1}{16}$ 11 C.W. B.T.

14" La. bears S15W 13.5'
dist. mkd. $\frac{1}{16}$ C.W. 511 B.T.

Witness: O. A. Keatley

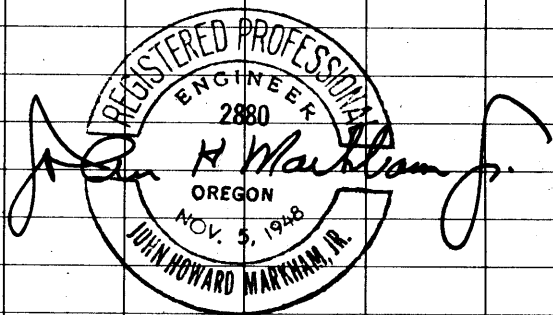

Work done for Stoman Lbr. Co.

C. S. File No. 42/922-9