

Feb. 23, 1960

N. W. Cannon Sec. 15 T30S

R2W W.N. as det. by O.B.T.

13" Fin S22E 33.7' O.B.T.

10" Fin S35W 26.4' O.B.T. fd. scribe

At cor. pt. fd. 12" Fin mkd.
on 4 faces of set $3\frac{1}{4} \times 30$ " I.P.

from which


10" White Fin bears S50E

14.4' dist. mkd. S15 x B.T.

18" Cedar bears S21W 47.0'

dist. mkd. S16 R2W B.T.

Witness: O. A. Keatley

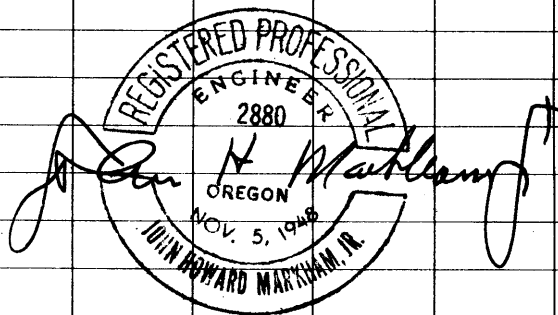

Work done for Staman Abr. Co.

C. S. File No. 42/421-10