

Feb. 23, 1960

'14 Corn 9-10 T30S R2W

W.M. as det. by O.B.T.S.

16" W. Fir Snag S22E 17.8' O.B.T.

17" W. Fir Snag N47W 6.0' O.B.T.

At con pt. fd. 30" Fir Snag
scribed on West face & set $3\frac{1}{4} \times 30$ " W.


from which

9" Cedar N33E 21.7' mhd. $\frac{1}{4}$ S 10 B.T.

9" Cedar N59E 27.0' mhd. $\frac{1}{4}$ S 10 B.T.

9" W. Fir S80E 24.0' mhd. $\frac{1}{4}$ S 10 B.T.

Witness: D.A. Keatley

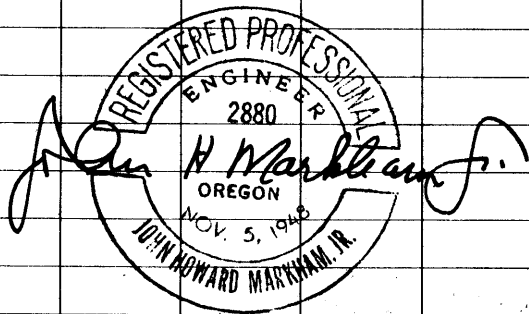

Work done for Stama Lbr Co.

C. S. File No. 42/421-12