

Feb. 23, 1960

1/4 Corner 10-11 T30S R2

W.N. as det. by O.B.T.s

15" W. Fir snag N29W 21.3' B.T.

45" Fir up root S47E 19.1'

dist. O.B.T. fd. scribe.

At cor. pt. fd. stone and  
set 1 1/2" x 30" I.P.

from which

7" W. Fir bears S18W 34.0'  
dist. mkd. '14510 B.T.


11" W. Fir bears S33E 44.7' dist.  
mkd. '14511 B.T.

4" Cedar bears S75E 25.7'  
dist. mkd. '14511 B.T.

15" Cedar bears N11W 41.0'  
dist. mkd. '14510 B.T.

Road bears South 450.0'

Witness: O.P. Keatley

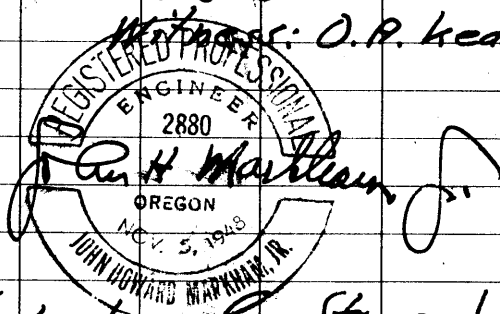

Work done for Stoman Lbr Co.

C. S. File No. 42/421-13