


Mar 24, 1960

South $\frac{1}{4}$ Corner Sec. 12 only
T305 R2W W.M. as det. by Q.B.T.
20" Fir uproot N40E 5.9' fd. scribe.
At cor. pt. set $\frac{1}{2} \times 30$ " I.P.
from which

9" Cedar S21W 36.5' mhd. '4512 B.T.
28" Cedar N47W 41.0' mhd. '4512 B.T.
North $\frac{1}{4}$ Cor. 13 bears West 58.0' dist.
Witness: D. A. Keatley

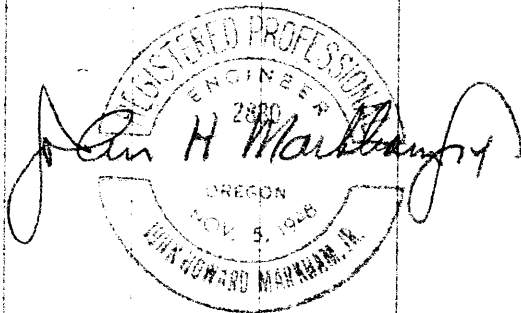

Work done for Stoman Lbr. Co.

C. S. File No. 42/421-15