

Mar. 24, 1960

Section Corner 3-4-9-10, T30S

R2W, W.M. as det. by O.B.T.U.

36" Cedar S36W 6.0' O.B.T. fld. scribe

7" Dead Cedar S15E 6.0' O.B.T. fld. scribe

9" Cedar N18E 11.2' O.B.T. fld. scribe

16" Fir N25W 11.2' O.B.T.

At corner point found stone &
set $\frac{1}{2}$ " x 30" I.P.

From which


12" Cedar S31E 10.4' mkd. S10 R2W B.T.

24" La. bears N82E 11.0' dist. mkd.

S3 T30S R2W B.T.

10" Cedar N35W 19.8' mkd. S4 R2W B.T.

Witness: D. A. Keatley

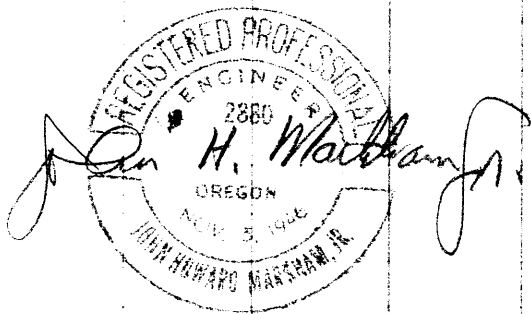

Work done for Stoman Lbr. Co.

C. S. File No. 42/421-17