

7-10-62

1/4 corner 15/16 T305 R2W, W.N.

as det. by O.B.T.S

25" Fir up root N75W 10.6' O.B.T.

20" Fir snag S20E 3.3' O.B.T.

At cor pt. set 1/2" x 1/2" angle iron


30" Long. from which

30" Cedar S32W 40.7' mkd. 1/4s 16 B.T.

18" Fir N80E 33.0' mkd. 1/4s 15 B.T.

50" Fir S35E 21.7' mkd. 1/4s 15 B.T.

Witness: J. P. Markham

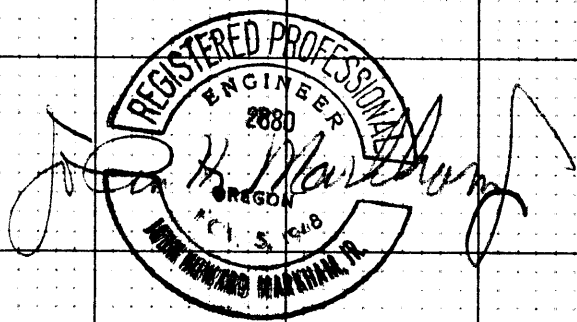

+O/

C. S. File No. 42/421-20

Work done for Stomer Lbr Co.