

7-10-62  
Sec. Corner 15-16-21-22 T30S

R2W. W.M. as det. by O.B.T.S.

12" Lrg. N25°W 24.4' OBT fd. scribe

20" Fir uproot S54W 6.6' OBT.

22" Fir uproot. N41E 10.6' OBT.

At corner point fd. stone & set

1½" x 30" I.P. from which


10" Cedar N47W 7.8' S16 B.T.

9" White Fir bears North 28.7' S15 B.T.

5" Fir N18E 21.0' mkd. SXXX B.T.

15" Fir N62E 42.0' mkd. S55 B.T.

Witness: J. R. Markham

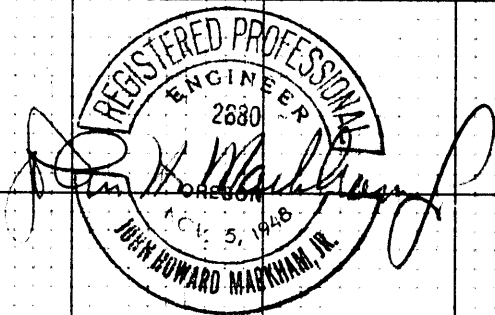

+O ✓ Mark done for Stamer Abr. Co. C. S. File No. 12/121-2