

RESTORED CORNER FOR OREGON STATE BOARD OF FORESTRY

One Quarter corner common to Sections 21 and 22,  
T23S, R10W, W.M., Douglas and Coos Counties,  
Oregon.

ORIGINAL

Post (found, down and rotted) from which a:

- 16" Fir bears N8W 23 lks.; now 30", face covered.
- 16" Fir bears S78E 10 lks.; now 17" x 48" high stub, portion of face exposed, scribes 22 visible.

RESTORED

Var. 20°E


Set 1½" x 36" galvanized iron pipe with 3" bronze cap marked "OREGON STATE BOARD OF FORESTRY 1/4 S21 S22 1959 RS359", 33 inches in ground, and from which a:

- 31" Fir bears S56W 10.9 ft.; scribed RS359.
- 26" Fir bears S86E 27.7 ft.; scribed 1/4 S22 BT.

Oregon State Board of Forestry metal location poster on original 16" Fir BT.

Dated August 4, 1959

Restored by Elbert Driver under my direction.  
Elbert Driver, Transitman

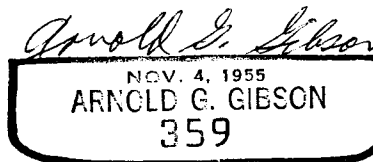

Present and witnessed by George Shore  
Robert Banks

FILED  
RECEIVED

AUG 21 1959

COUNTY SURVEYOR  
DOUGLAS COUNTY, ORE.