

ESTABLISHED CORNER FOR OREGON STATE BOARD OF FORESTRY  
(See official plat)

Closing Section corner common to Sections 33 and 34, T23S,  
R10W, W.M. Coos County, Oregon.


ESTABLISHED

Set  $1\frac{1}{2}$ " x 36" galvanized iron pipe with 3" bronze cap marked "Oregon  
State Board of Forestry T23S R10W CC S33 S34 S3 T24S R10W 1960  
RS359", 30 inches in ground,  $S0^{\circ}31'E$  3.7 ft. from original closing  
corner which I mark AM on the pipe cap and AM on each of the  
bearing trees.

Present and witnessed by R. Jones

Dated August 23, 1960

Established by David Steenson under my direction.  
David Steenson, Transitman

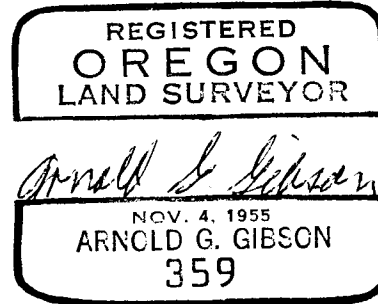

Note: A plat showing the subdivision of Sections 32 and 33 T23S, R10W  
has been sent to the Coos County Surveyor in Coquille, Oregon.

FILED  
RECEIVED

1960

COUNTY SURVEYOR  
DOUGLAS COUNTY, ORE.