

RESTORED CORNER FOR STATE OF OREGON--DEPARTMENT OF FORESTRY

One Quarter corner common to Sections 27 and 34, T23S,  
R10W, W.M., Douglas County, Oregon.

ORIGINAL

Fir Post (now missing) from which a:

- 13" Fir bears S53E 14 lks.; now 17", exposed scribes S34.
- 13" Fir bears N59W 19 lks.; now 25", face grown over.

RESTORED


Set 1½" x 36" galvanized iron pipe with 3" bronze cap marked "OREGON STATE BOARD OF FORESTRY 1/4 S27 S34 1961 RS359", 32 inches in ground, in mound of stone, and from which a:

21" Fir bears N16W 51.1 ft.; scribed RS359.

Oregon State Board of Forestry metal location poster on ~~2100 ft. N59W 19 lks.~~ original 13" Fir BT. NW  
Set 4" x 4" x 72" white painted Cedar post 1.5 ft. NE of pipe.

Dated November 22, 1961

Restored by Donald L. McConnell under my direction.  
Donald L. McConnell, Transitman

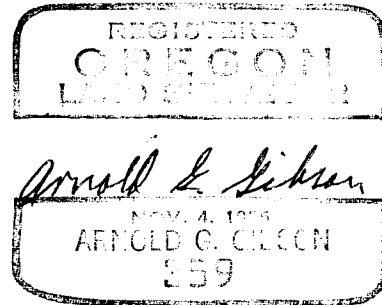

Present and witnessed by P. Lewellyn  
M. Pounds

FILED  
RECEIVED

DEC 14 1961

COUNTY SURVEYOR  
DOUGLAS COUNTY, ORE.

42/422-8