

1/4 Corner $\frac{9}{16}$ T 31 S-R 5 W - WM


FOUND: 16" White Fir S 4° W 18 LKS (since destroyed by logging).
6" White Fir tree monument for the corner. Blown down but still green. I chopped into the north face and disclosed the scribing - 1/4 S -. I chopped off the top leaving about a 4' stump as a memorial. The negative of the scribing is retained in our office.

SET: 1 1/2" Iron pipe 48" long 36" in the ground.
Due to the fact that there are no trees to the South I set 2 new Bearing Trees in Section 9.

12"	White Fir	N 64° W - 41.3'	scribed	1/4 S 9 BT
12"	Yew	N 74° E - 38.5'	scribed	1/4 S 9 BT

WITNESS:

Charles C. Jones

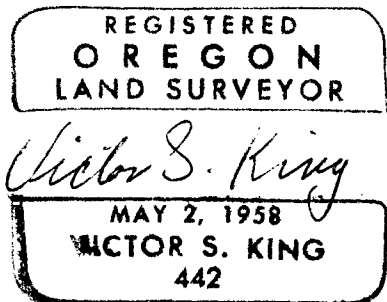

FILED
RECEIVED

FEB 5 1959

COUNTY SURVEYOR
DOUGLAS COUNTY, ORE.