

1/4 Corner $\frac{14}{23}$

T 31 S-R 5 W - WM


FOUND: Basalt Stone 15" x 10" x 8" marked 1/4 from which a Fir snag, burned off nearly flush with the ground, bears N 22° W 13 LKS. There is no sign of the cedar BT that should have been on a rock outcrop. This BT very easily could have blown over, burned and left no evidence.

SET: $1\frac{1}{2}$ " iron pipe 36" long Set 30" into a mound of stones. It replaces the original stone that is left there as a memorial. This corner falls at the East Base of a solid rock outcrop 10' high and is in an old burn, there are no trees available for Bearing Trees. I marked 2 Bearing objects, both are 4" +'s chiseled into the rock outcrop

4" \neq N 68° W 8.5'
4" \neq S 50° 30' W 2.2'

WITNESS:

Charles C. Jones

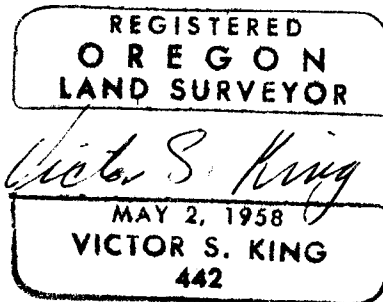

FILED
RECEIVED

FEB 5 1958

COUNTY SURVEYOR
DOUGLAS COUNTY, ORE.

C. S. File No. 72/425³