

5 4


1/4 Cor. - Fd. 2 old B.T stumps
Set I.P. - mkd new B.T's
18" Fir - N63°W 28.6
16" Fir - N88°E 29.0

663.93

West
Set points to define line

1/16 Cor. - Set 1/2" x 30" I Rod,
3" x 3" x 30" post alongside

N0°37'E 1327.86
663.93

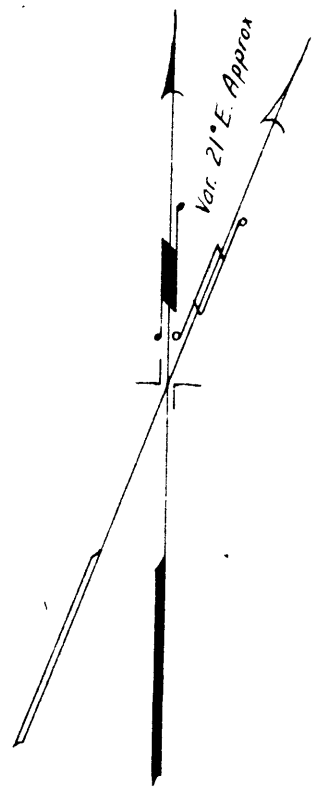

SW Cor. Lot 66 - Eden Orchards
Fd 1" x 30" I.P.
Dedicated Road
Fd. I.P.

COUNTY SURVEYOR'S OFFICE
DOUGLAS COUNTY, OREGON

Ben B. Irving

SURVEY TO ESTABLISH N.E. CORNER
OF S.E. 1/4, S.E. 1/4, SEC. 5, T27S., R7W.

BEN. B. IRVING COUNTY SURVEYOR
SURVEYED DEC. 20, 1948. SCALE 1" = 100'

C. S. File No. 43/10