
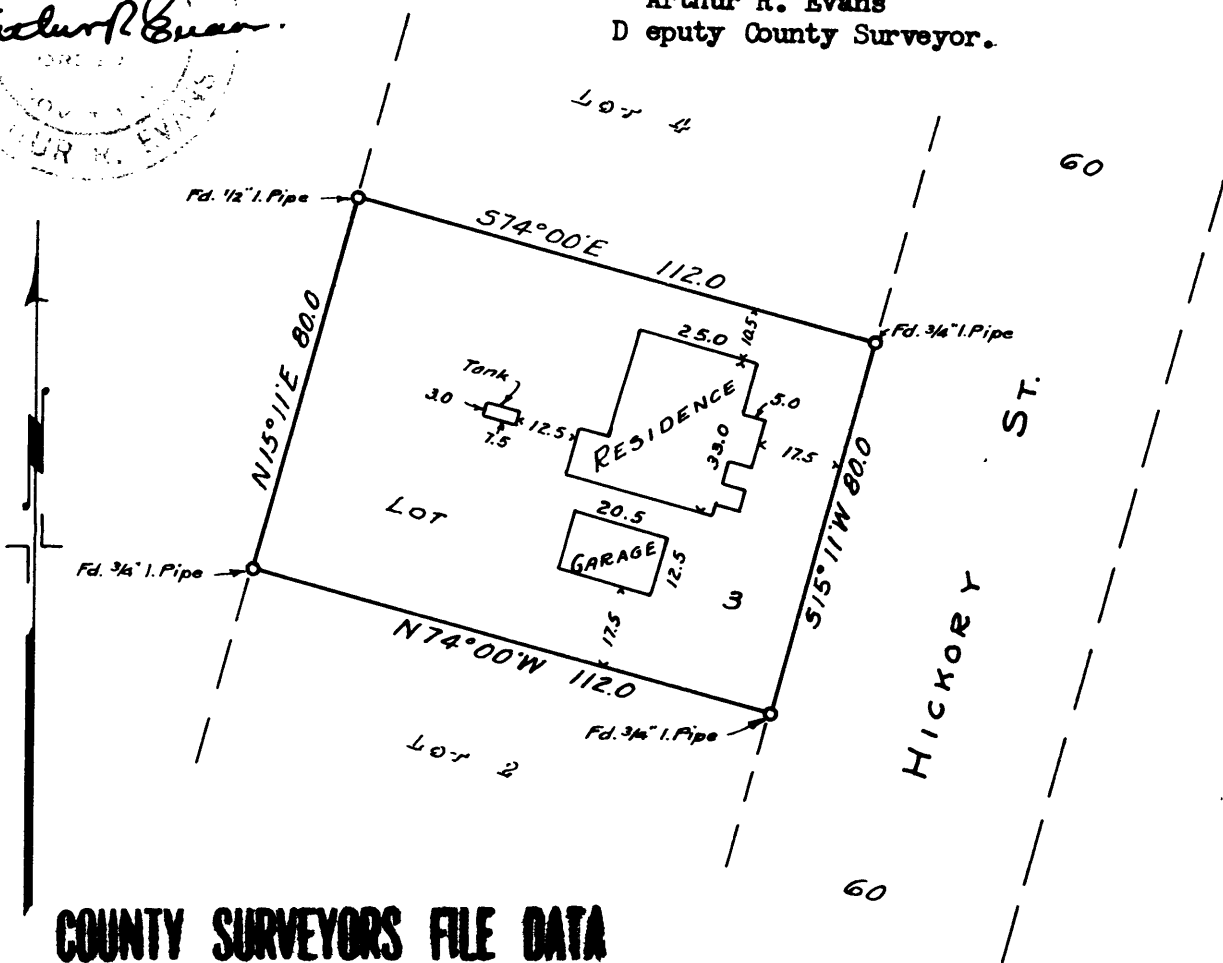


**MAP**  
 SHOWING LOCATION OF  
 RESIDENCE ON & BOUNDARIES OF  
 LOT 3, BLOCK 3, CLOAKES FERRY  
 IN THE  
 COUNTY OF DOUGLAS  
 AND  
 STATE OF OREGON  
 SURVEYED 7-25-49 SCALE 1"=40'

I hereby certify that I have surveyed the above described property and that the improvements shown and described hereon are within the property lines.



  
 Arthur R. Evans  
 Deputy County Surveyor.



**COUNTY SURVEYORS FILE DATA  
DO NOT REMOVE FROM OFFICE**