

MAP  
 SHOWING LOCATION OF  
 RESIDENCE ON & BOUNDARIES OF  
 LOT 9, BLOCK 6, "NEBO-VISTA HOMES"  
 IN THE  
 COUNTY OF DOUGLAS  
 AND  
 STATE OF OREGON


SURVEYED 6-22-49

SCALE 1"=30'

I HEREBY CERTIFY THAT I HAVE SURVEYED THE ABOVE DESCRIBED PROPERTY, AND THAT THE IMPROVEMENTS SHOWN AND DESCRIBED HEREON, AND SHOWN ON THIS SURVEY ARE WITHIN THE PROPERTY LINES.

*Arthur R. Evans*

REGISTERED ENGINEER  
 DEPUTY COUNTY SURVEYOR  
**COUNTY SURVEYORS FILE DATA  
 DO NOT REMOVE FROM OFFICE**

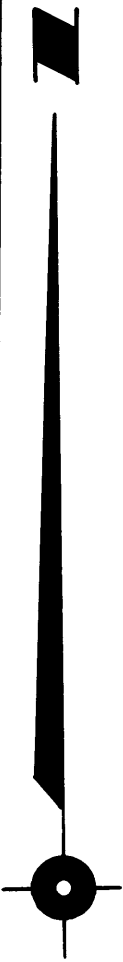

WEST LINE, NEBO-VISTA HOMES

N 0°52'E, 65°

LOT 10

EAST 107.38

LOT 9

RESIDENCE

STREET

50 NEBO

WEST 108.12

LOT 11

S 50°13'W, 65°

C. S. 43/54-1

FILE 542 DRAWER 43