

MELROSE COUNTY ROAD

$N 70^{\circ} 12' E 85.5$

Pipe

101.7

SUNSET LANE

$N 0^{\circ} 12' E 201.7$

100

SOUTH 100 FT. LOT 1

$S 0^{\circ} 12' W 219.5$

COUNTY SURVEYORS FILE DATA  
DO NOT REMOVE FROM OFFICE

20.3  
Concrete Drive

20.8

10.5

15.4

28.0

DWELLING

18.7


30.2

9.4

$N 89^{\circ} 48' W 83.6$

LOT 3

Pipe. SW Cor. Lot 21.

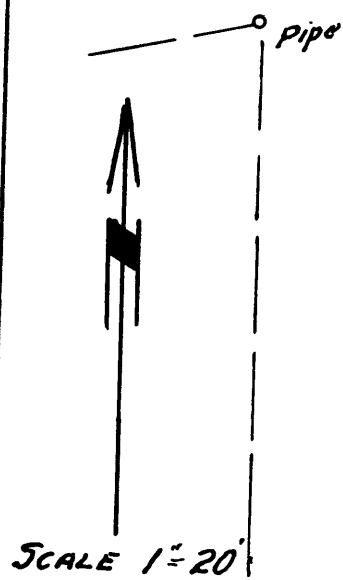

LOT 2



MAP SHOWING LOCATION OF RESIDENCE ON & BOUNDARIES OF  
SOUTH 100 FT. LOT 1, "LUELLEN ACRES"

COUNTY OF DOUGLAS

STATE OF OREGON

I hereby certify that I have surveyed the above described property  
and that the improvements shown and described hereon are within  
the property lines.

*Ben B. Irving*  
BEN. B. IRVING  
County Surveyor.

SURVEYED OCTOBER 19, 1949