


COUNTY SURVEYORS FILE DATA
DO NOT REMOVE FROM OFFICE

MAP SHOWING LOCATION OF IMPROVEMENTS
ON AND BOUNDARIES OF
LOT 22 "LUELLEN ACRES"
COUNTY OF DOUGLAS - STATE OF OREGON
SURVEYED OCTOBER 19, 1949 SCALE 1"=20'

I hereby certify that I have surveyed the above
described property, and that the improvements shown
hereon are ~~within~~ the property lines.

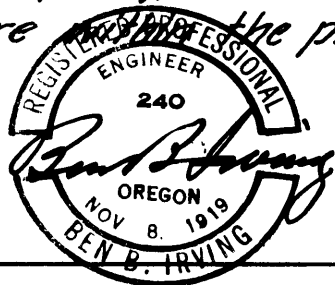

Ben B. Irving
BEN. B. IRVING
County Surveyor.