


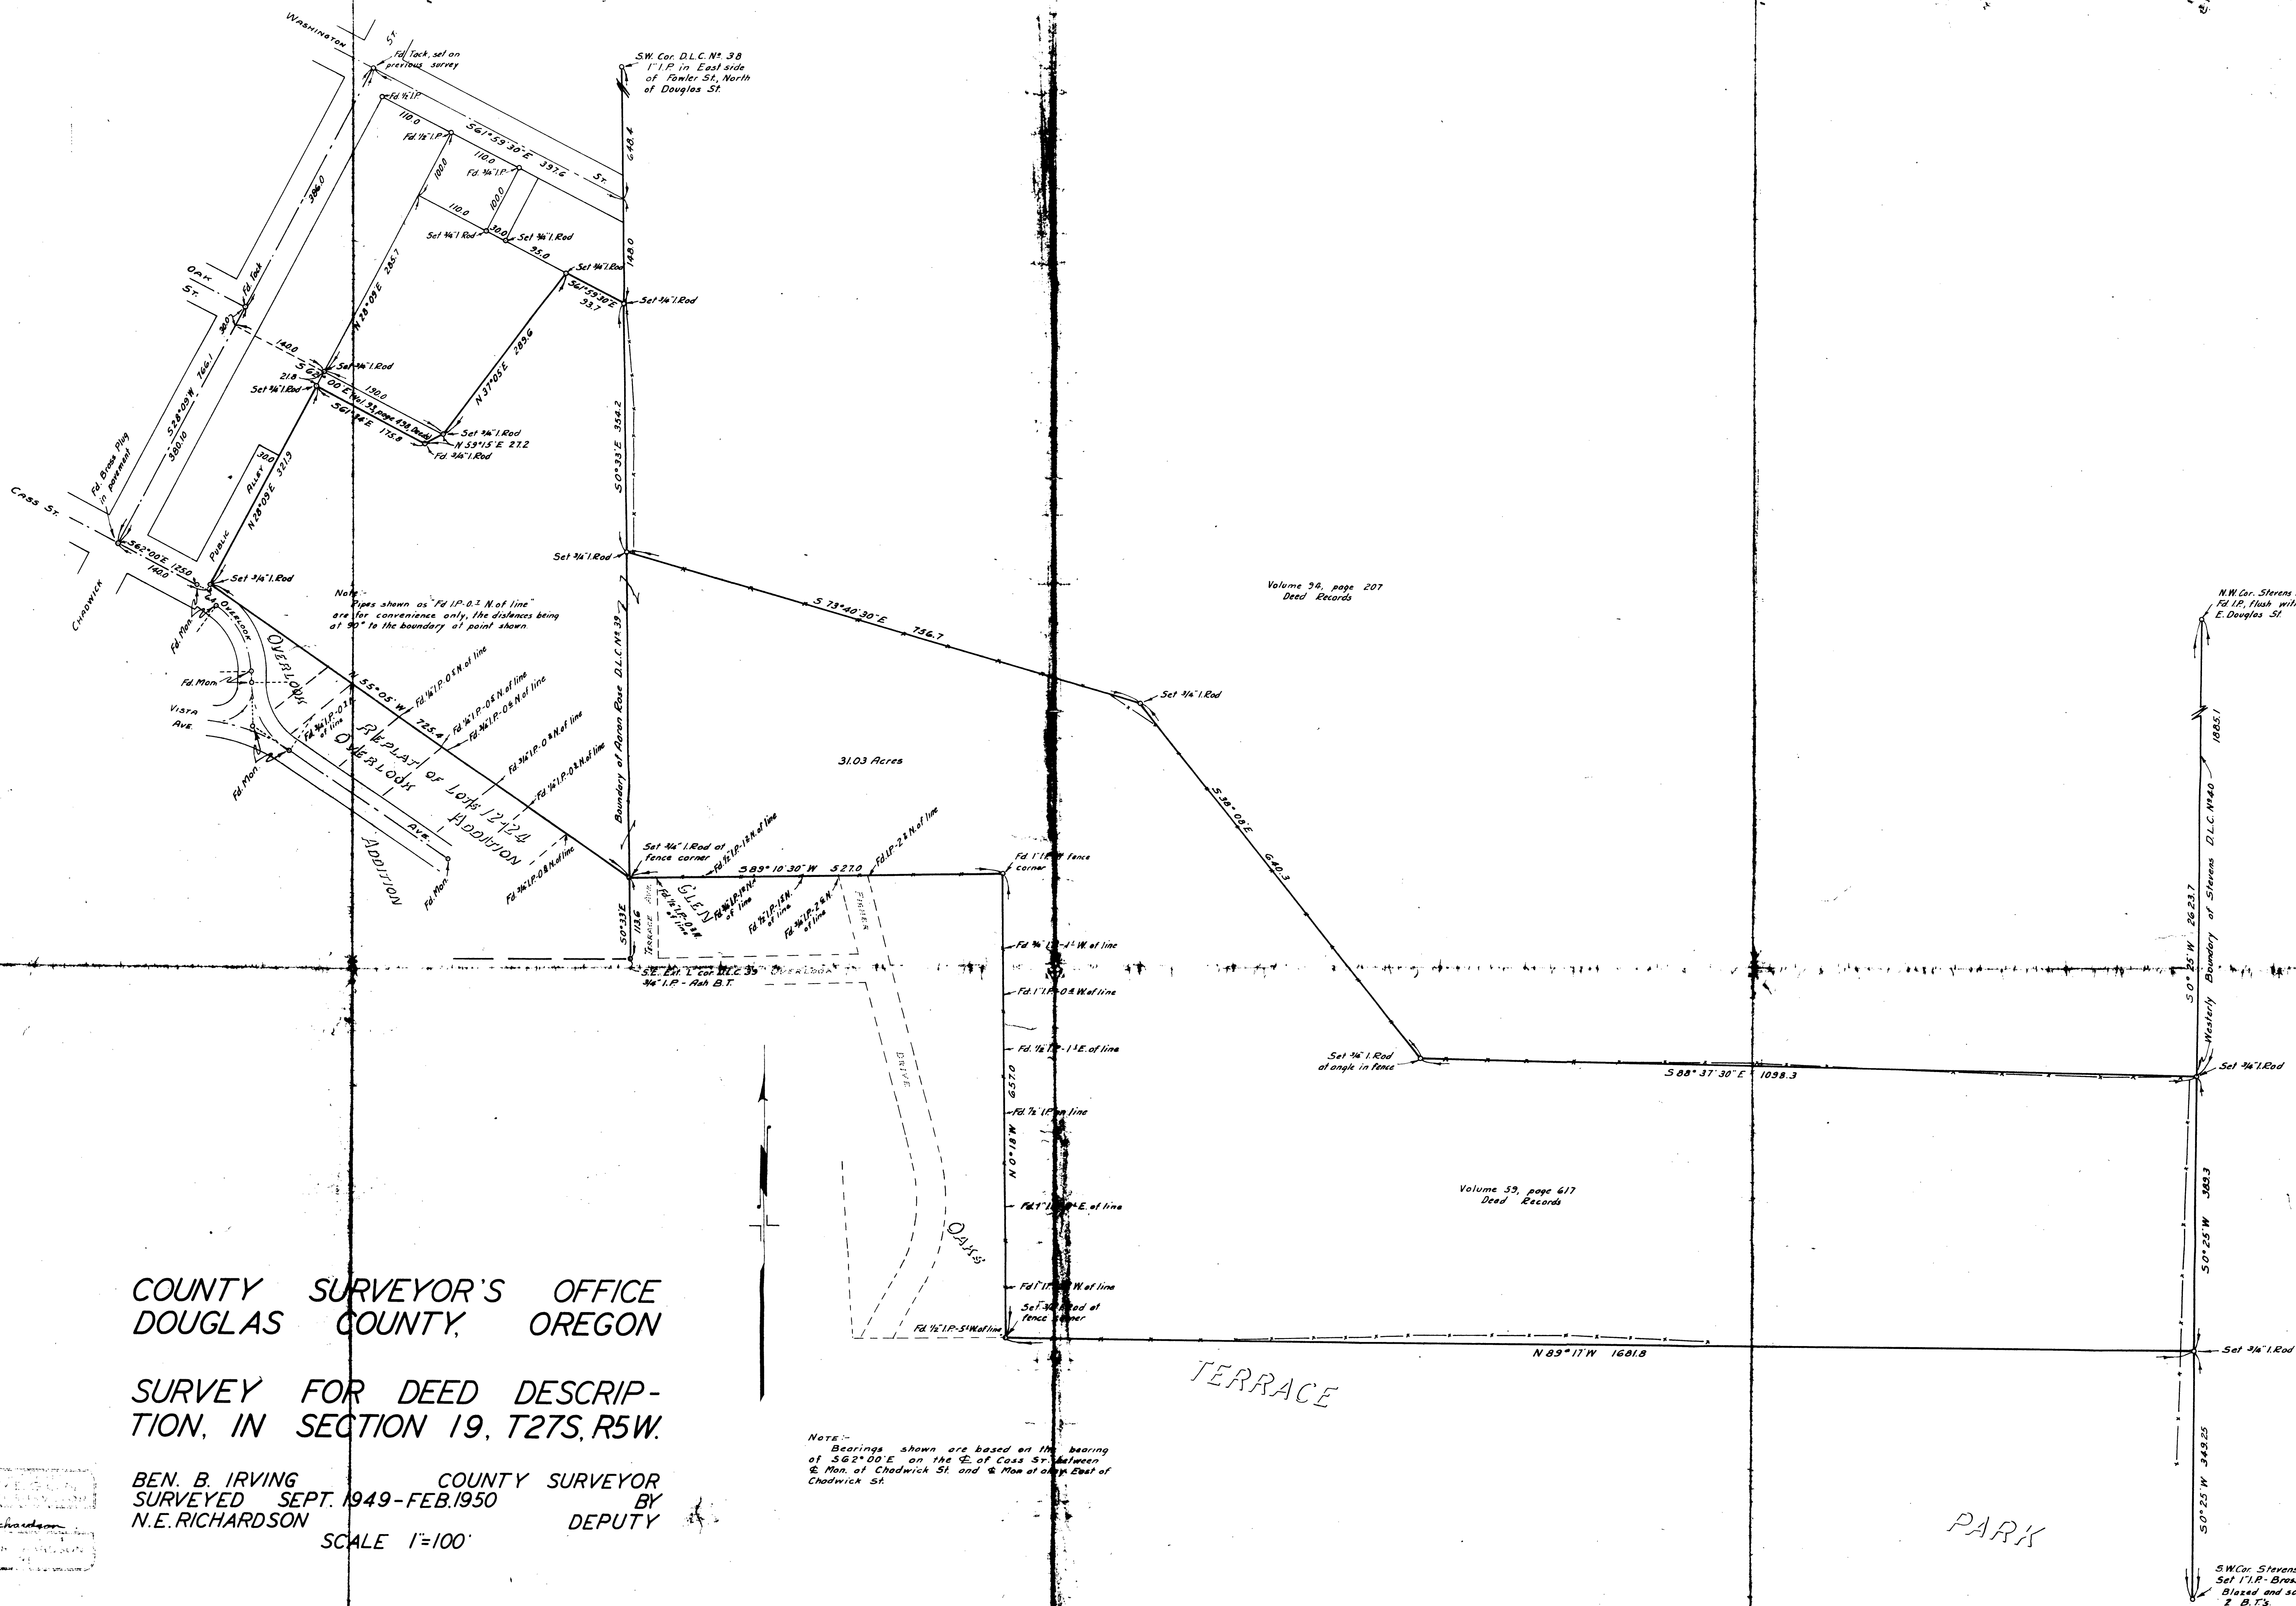


COUNTY SURVEYOR'S OFFICE
DOUGLAS COUNTY, OREGON

SURVEY FOR DEED DESCRIPTION,
IN SECTION 19, T27S, R5W.

BEN. B. IRVING COUNTY SURVEYOR
SURVEYED SEPT. 1949-FEB. 1950 BY
N.E. RICHARDSON DEPUTY

SCALE 1"=100'

NOTE: Bearings shown are based on the bearing of S 62° 00' E on the E. of Cross St. between E. Mon. at Chadwick St. and E. Mon. at angle East of Chadwick St.

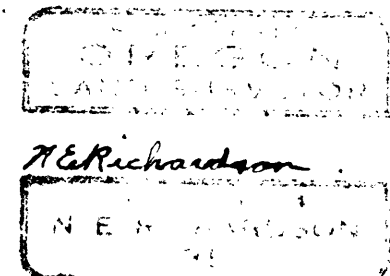

N.W. Cor. Stevens D.L.C. #40
Fd. I.P. flush with pvm. in
E. Douglas St.

SW Cor. Stevens D.L.C. #40
Set 1" I.P. Brass Cap
Blazed and scribed
2 B.T.'s

CS 44/35
CS 44/3

CS FILE FOLDER

CONTAINS

MORE

INFORMATION