


MAP
SHOWING LOCATION OF
RESIDENCE ON & BOUNDARIES OF
WEST 1/2 LOT 1 BLOCK 4 NORTH PARK ADDITION ROSEBURG
IN THE
COUNTY OF DOUGLAS
AND
STATE OF OREGON
 SURVEYED 7-25-49 SCALE 1"=50'

I hereby certify that I have surveyed the above described property,
 and that the improvements shown and described hereon are within the
 property lines.

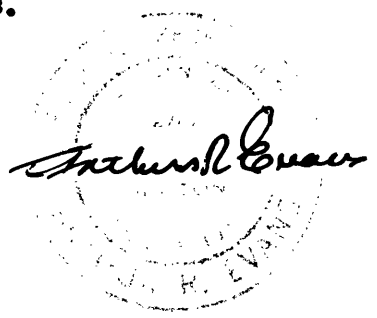

Arthur R. Evans
 ARTHUR R. EVANS
 Deputy County Surveyor

COUNTY SURVEYORS FILE DATA
DO NOT REMOVE FROM OFFICE

