


T 265 R 5 W

Found Orig B.T.s in NE Quad
& SW quad From These Set
1" x 4' Axle 3'6" inground To
Mark sec. Cor. $\frac{9}{16} | \frac{10}{15}$ From This
found stump & Stamp hole
Corresponding to remaining B.T.s

Marked Trees as follows

N 46 W	39.5'	8" white oak
S 63 1/2 W	19.8	24" white oak
S 98 E	89.0	12" " "

G. E. Crowder
Chief of Party
County Engineers
Office

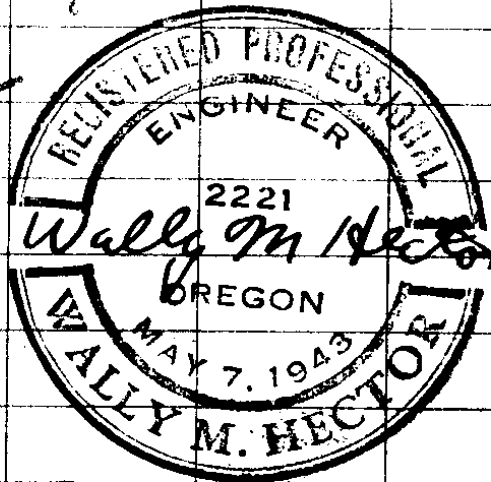

44/47 - 5

✓

in depth by course in course etc.