


Notes On Resetting
1/4 Cor Between 25 & 26
Township 26 S R 7 W

⊙ 17" N Fir

N 32 3/4 E

73.5

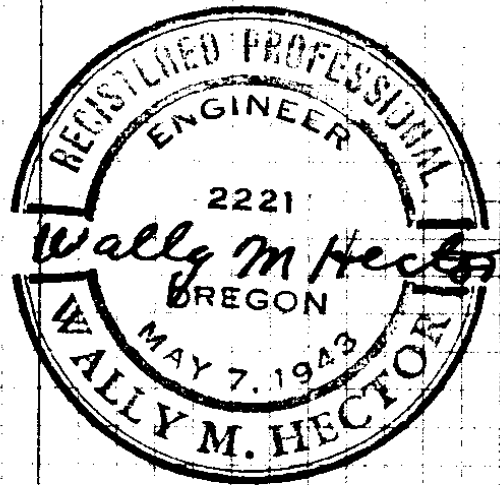

⊙ 1/4 Cor. set 1/2" x 36" I.P.

Found Old Witness Tree stump
SW 67 & 68.

44-49

44/479