

Relocation  $\frac{1}{4}$  Corner Sec 26+35  
T29S R9W WBM

From stump of 10" Oak N89W 10.2'  
I set a 1" x 36" Bolt 30" in ground  
Marked 2 New Trees  
A 10" Fir N70°30'W 77.9'  
A 18" White Oak N59°30'W 123.0'

Marked  $\frac{1}{4}$  S T29S R9W Sec 26

November 21, 1951


HE Crowder

Witness John Stanley

FILED  
RECEIVED

DEC 11 1951

COUNTY SURVEYOR  
DOUGLAS COUNTY, ORE.

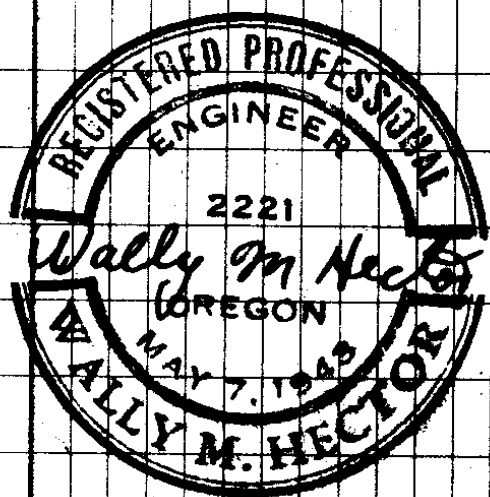

44-47

*not in  
concordance*

44-47-10