


FOUND ONE O.B.T. STANDING
8" W OAK (NOW 15"), N23°W, 55 LKS
SET 3/4" IRON ROD FOR CORNER.
BLAZED & SCRIBED NEW B.T.'S
20" FIR, S32°W, 30.3 FT
MKD T27S, R3W, S6 C.S.B.T.
30" B. OAK, N45°W, 65° FT
MKD T26S, R3W, S31, C.S.B.T.
NO OTHER SUITABLE TREES
AVAILABLE

1/4 COR. SECS 5-32 SET
BY PROPORTIONATE MEAS.
SET 1" IRON PIPE WITH
BRASS CAP MKD T26S, R3W
S32, T27S, R3W, S5, CO SURV
OFFICE. BLAZED & SCRIBED
B.T.'S.
8" W. OAK, N60°W, 19 1/2 FT
MKD T26S, R3W, 1/4 S32, C.S.B.T.
8" W. OAK, S53°E, 53° FT
MKD T27S, R3W, 1/4 S5, C.S.B.T.

FOUND FOUR O.B.T.'S, 40" B. OAK, N15°W, 263.3 FT,
DEAD & DOWN, SCRIBE MARKS VISIBLE.
15" B. OAK, N70°E, 156.4 FT, DEAD & DOWN, SCR. MKS, VISIBLE
18" W. OAK, S26°W, 158.0 FT, ALIVE
24" LAUREL, S29°E, 52.1 FT (LIVE).
SET 3/4" IRON ROD & MOUND OF ROCK FOR CORNER.
BLAZED & SCRIBED NEW B.T.'S
24" CEDAR, N59°E, 74.5 FT MKD T26S, R3W, S33, C.S.B.T.
18" CEDAR, S53°E, 21° FT, MKD T27S, R3W, S4, C.S.B.T.
18" CEDAR, S42°W, 46° FT, MKD T27S, R3W, S5, C.S.B.T.
18" CEDAR, N64°W, 89° FT, MKD T26S, R3W, S32, C.S.B.T.


TRAVERSE DATA		
1-2-3 = TRAVERSE & STATIONS		
BEARINGS AND DISTANCES		OFFSET TO TRUE LINE
1/4 COR 5/8		
1	N 4°00' E, 755	48 WEST
2	N 0°53' W, 650	35 WEST
3	N 1°15'30" W, 1553	02 EAST
4	N 0°47' W, 5542	114 EAST
5	N 0°38'30" W, 1521	141 EAST
6	N 0°32'30" W, 1580	164 EAST
7	N 0°25' W, 2060	190 EAST
8	N 1°25' W, 1120	224 EAST
9	N 0°58' W, 1575	260 EAST
10	N 0°07' W, 900	267 EAST
11	N 0°58'30" W, 1884	300 EAST
12	N 0°39'30" W, 1131	320 EAST
13	N 0°52'30" W, 1280	350 EAST
14	N 0°12' W, 1250	367 EAST
15	N 0°56'30" W, 1151	390 EAST
16	N 0°54'30" W, 1470	424 EAST
17	N 0°51' W, 2950	484 EAST
18	N 0°42'30" W, 3050	530 EAST
19	N 0°33' W, 2290	570 EAST
20	N 0°35'30" W, 2591	610 EAST
21	N 0°37' W, 1200	634 EAST
22	N 1°31' W, 1651	680 EAST
23	N 1°23'30" W, 1190	720 EAST
24	N 1°21' W, 2870	800 EAST
25	N 1°08'30" W, 1220	830 EAST
26	N 0°57' W, 1970	880 EAST
27	N 0°59'30" W, 780	890 EAST
28	N 0°39'30" W, 2520	940 EAST
29	N 1°01'30" W, 990	960 EAST
30	N 3°09' W, 1790	1074 EAST
49	N 2°07' W, 770	
1/4 COR 7/8		
	S 88°56' E, 1100	

ALL BEARINGS SHOWN ARE TRUE AND WERE CALCULATED FROM ANGLES TURNED IN DEFLECTION FROM A TRUE MERIDIAN ESTABLISHED BY SOLAR OBSERVATION TAKEN DURING THE COURSE OF THIS SURVEY

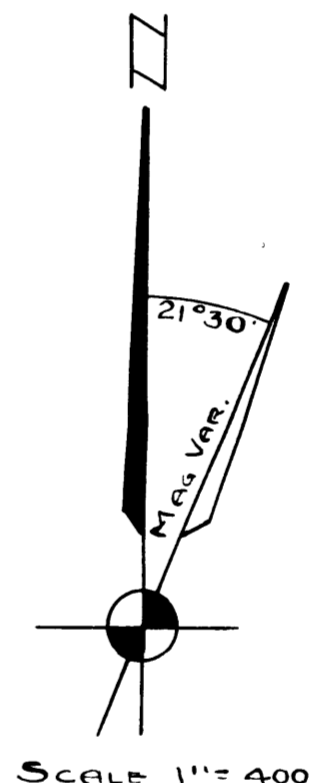

COUNTY SURVEYOR'S OFFICE
DOUGLAS COUNTY OREGON
SURVEY TO ESTABLISH
N. & S. MID-SECTION LINE
SECTION 5, T27S, R3W, WM.

BEN B. IRVING, COUNTY SURVEYOR
SURVEYED & PLATTED, OCT. 1950, BY
A. R. EVANS, DEP. COUNTY SURVEYOR

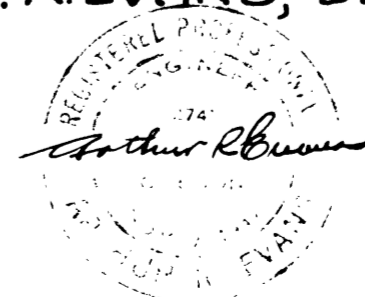

FD 1/2" IRON PIPE FOR CORNER
IDENTIFIED FROM 3 B.T.'S.
18" FIR, S20°W, 4 LKS.
18" FIR, N20°E, 4 LKS.
20" FIR, N65°E, 57 LKS

1/4 COR. SECS. 5 & 8

M 16-71

C.S. 44/41-1

CS FILE FOLDER

CONTAINS

MORE

INFORMATION