




BEARINGS ARE BASED ON BEARING OF OLD PACIFIC HIGHWAY

SCALE 1" = 30'

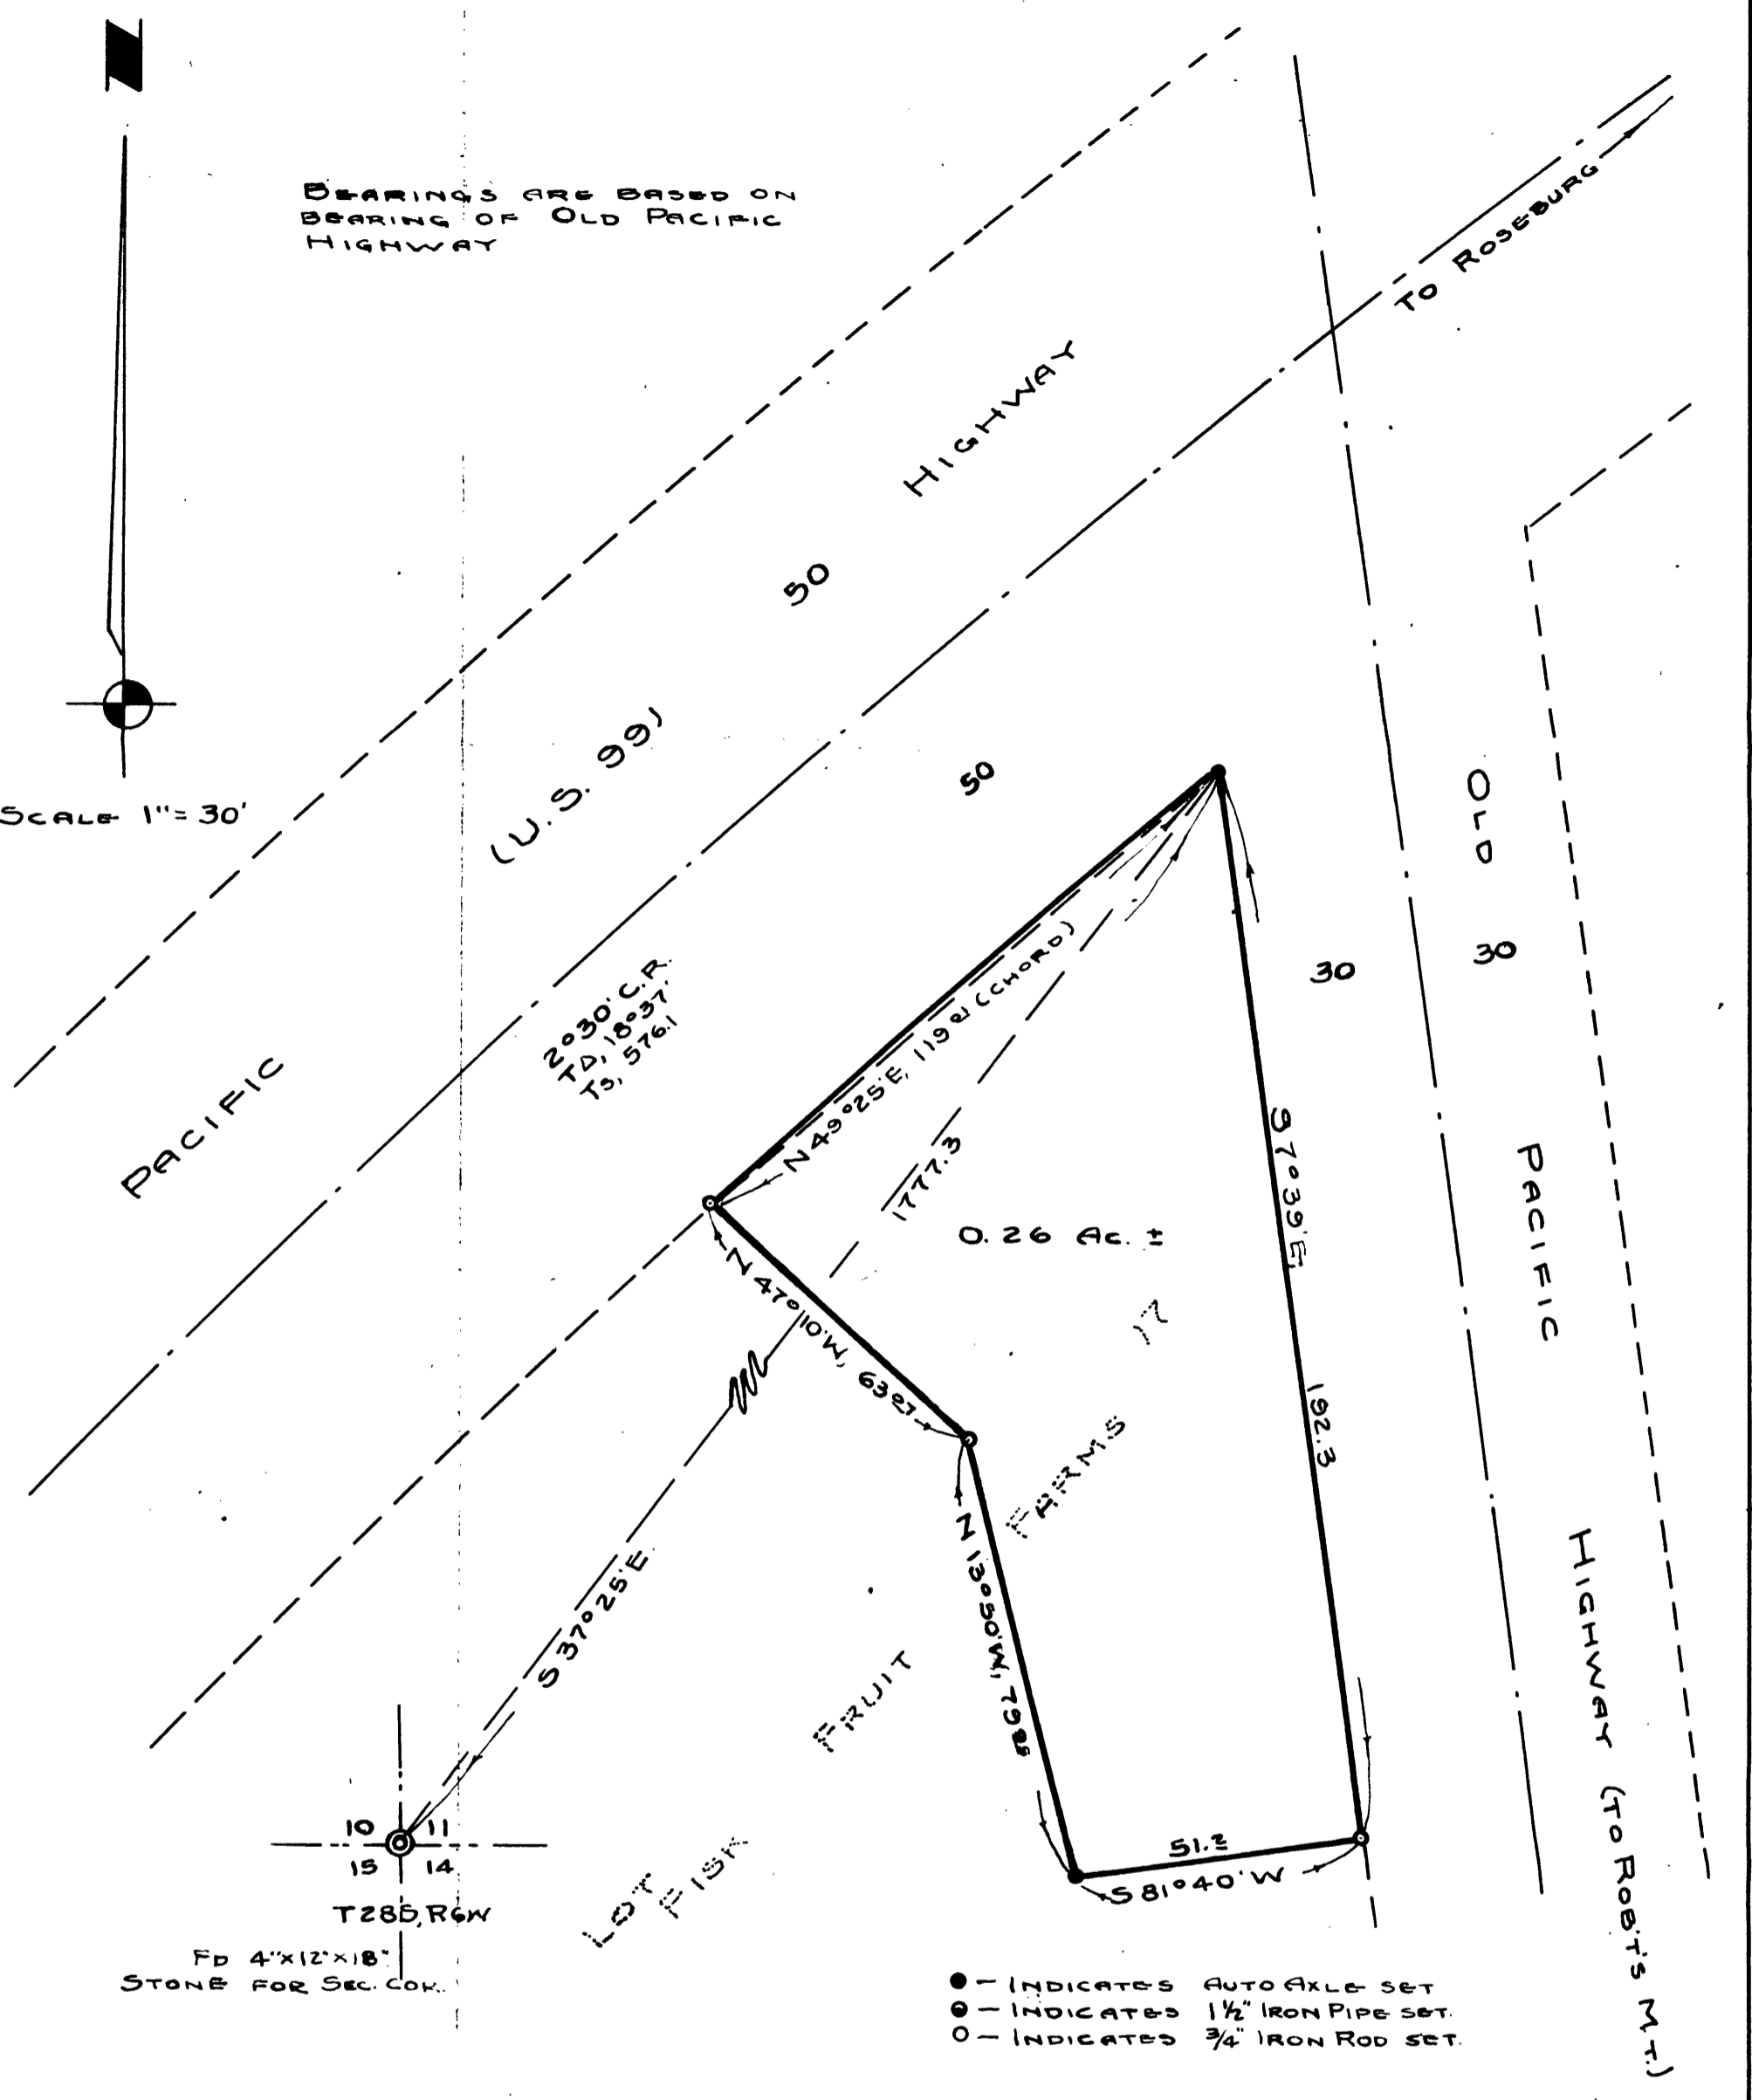

10 11  
15 14  
T285, R6W  
FD 4"x12"x18"  
STONE FOR SEC. COR.

- - INDICATES AUTO AXLE SET
- - INDICATES 1/2" IRON PIPE SET.
- - INDICATES 3/4" IRON ROD SET.

COUNTY SURVEYOR'S OFFICE  
DOUGLAS COUNTY OREGON  
SURVEY FOR DEED DESCRIPTION  
IN LOT 17, "FISK FRUIT FARMS"  
SECTION 11, T285, R6W, W.M.

REC'D  
10-20-50  
N.E. Richardson  
COUNTY SURVEYOR  
NOV 25 1950

BEN B. IRVING COUNTY SURVEYOR  
SURVEYED, NOV. 17-20, 1950, BY  
N.E. RICHARDSON DEPUTY