


Scale 1" = 60'

NOTE -
 Bearings shown are True, based on Solar
 Observation made Jan 27, 1947.
 Data shown () is from survey made by
 this office for Drain M.E. Church, on Aug. 23, 1948.

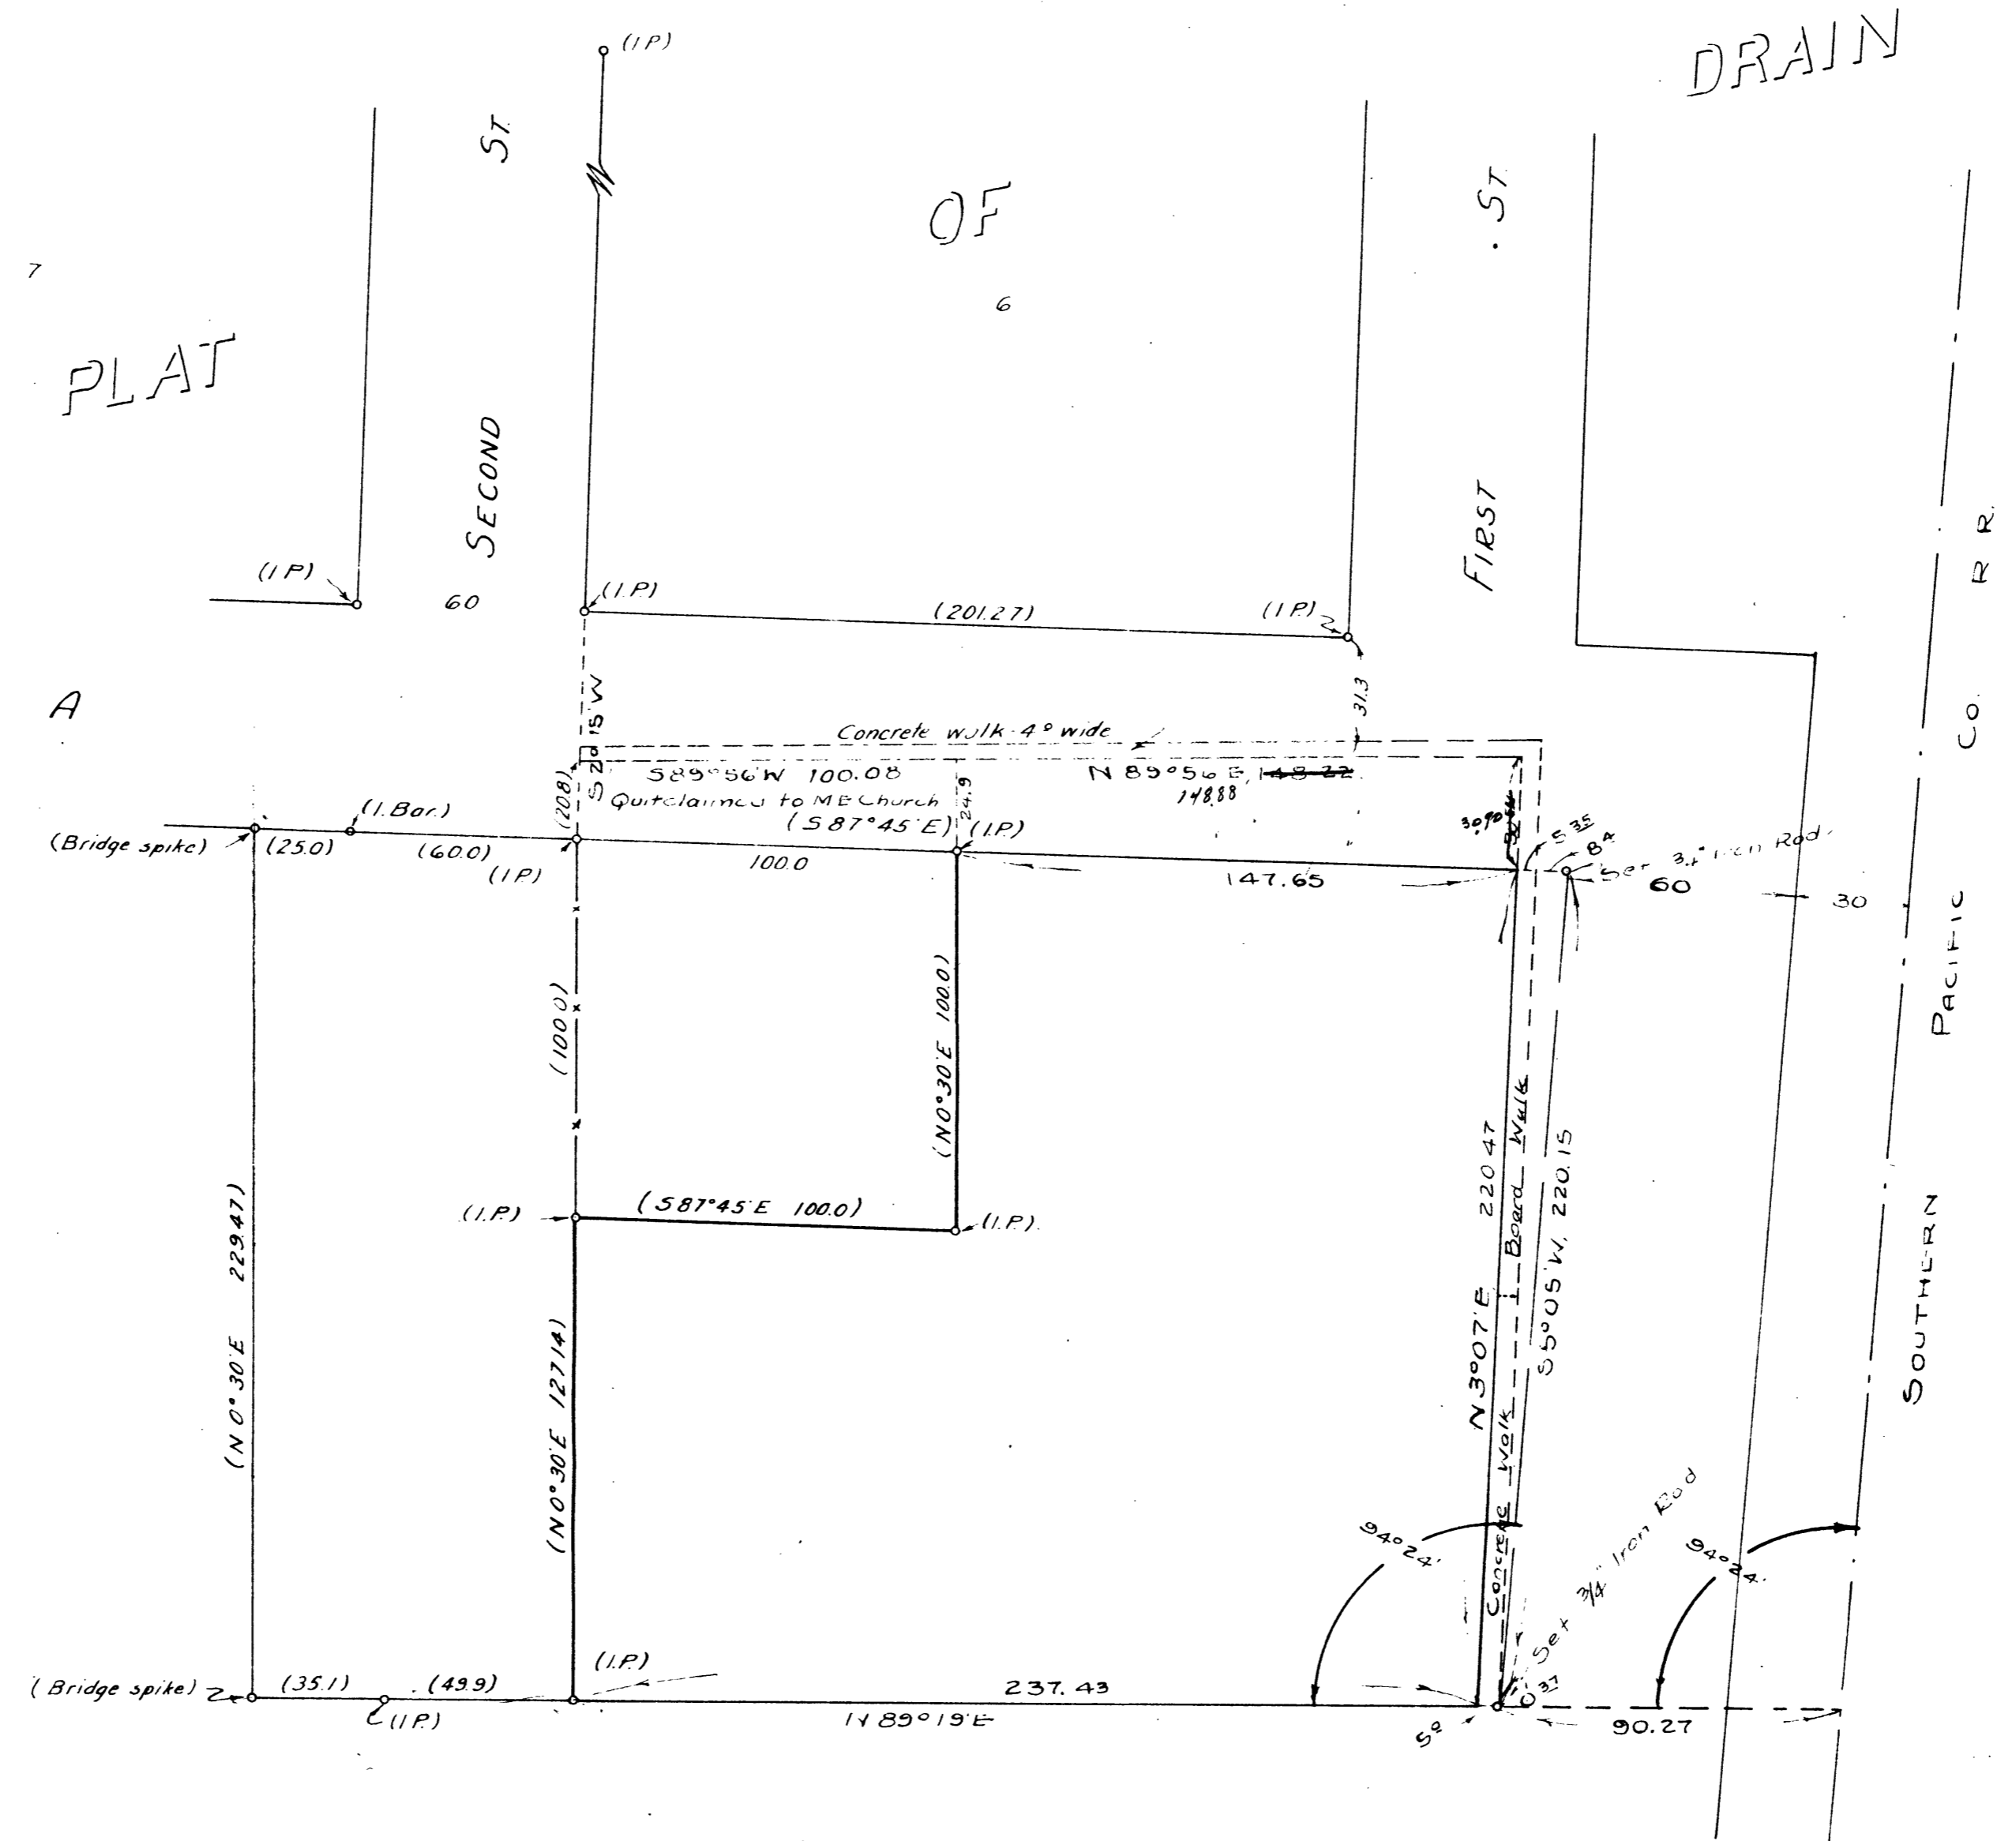

COUNTY SURVEYOR'S OFFICE
 DOUGLAS COUNTY OREGON
 SURVEY FOR MRS. M. HEDRICK
 DRAIN OREGON

M.E. Richardson

BEN B. IRVING COUNTY SURVEYOR
 SURVEYED, JUNE 14, 1950, BY
 N.E. RICHARDSON DEPUTY