


C.S. FILE # 99/81
M/O-73

UMPQUA RIVER

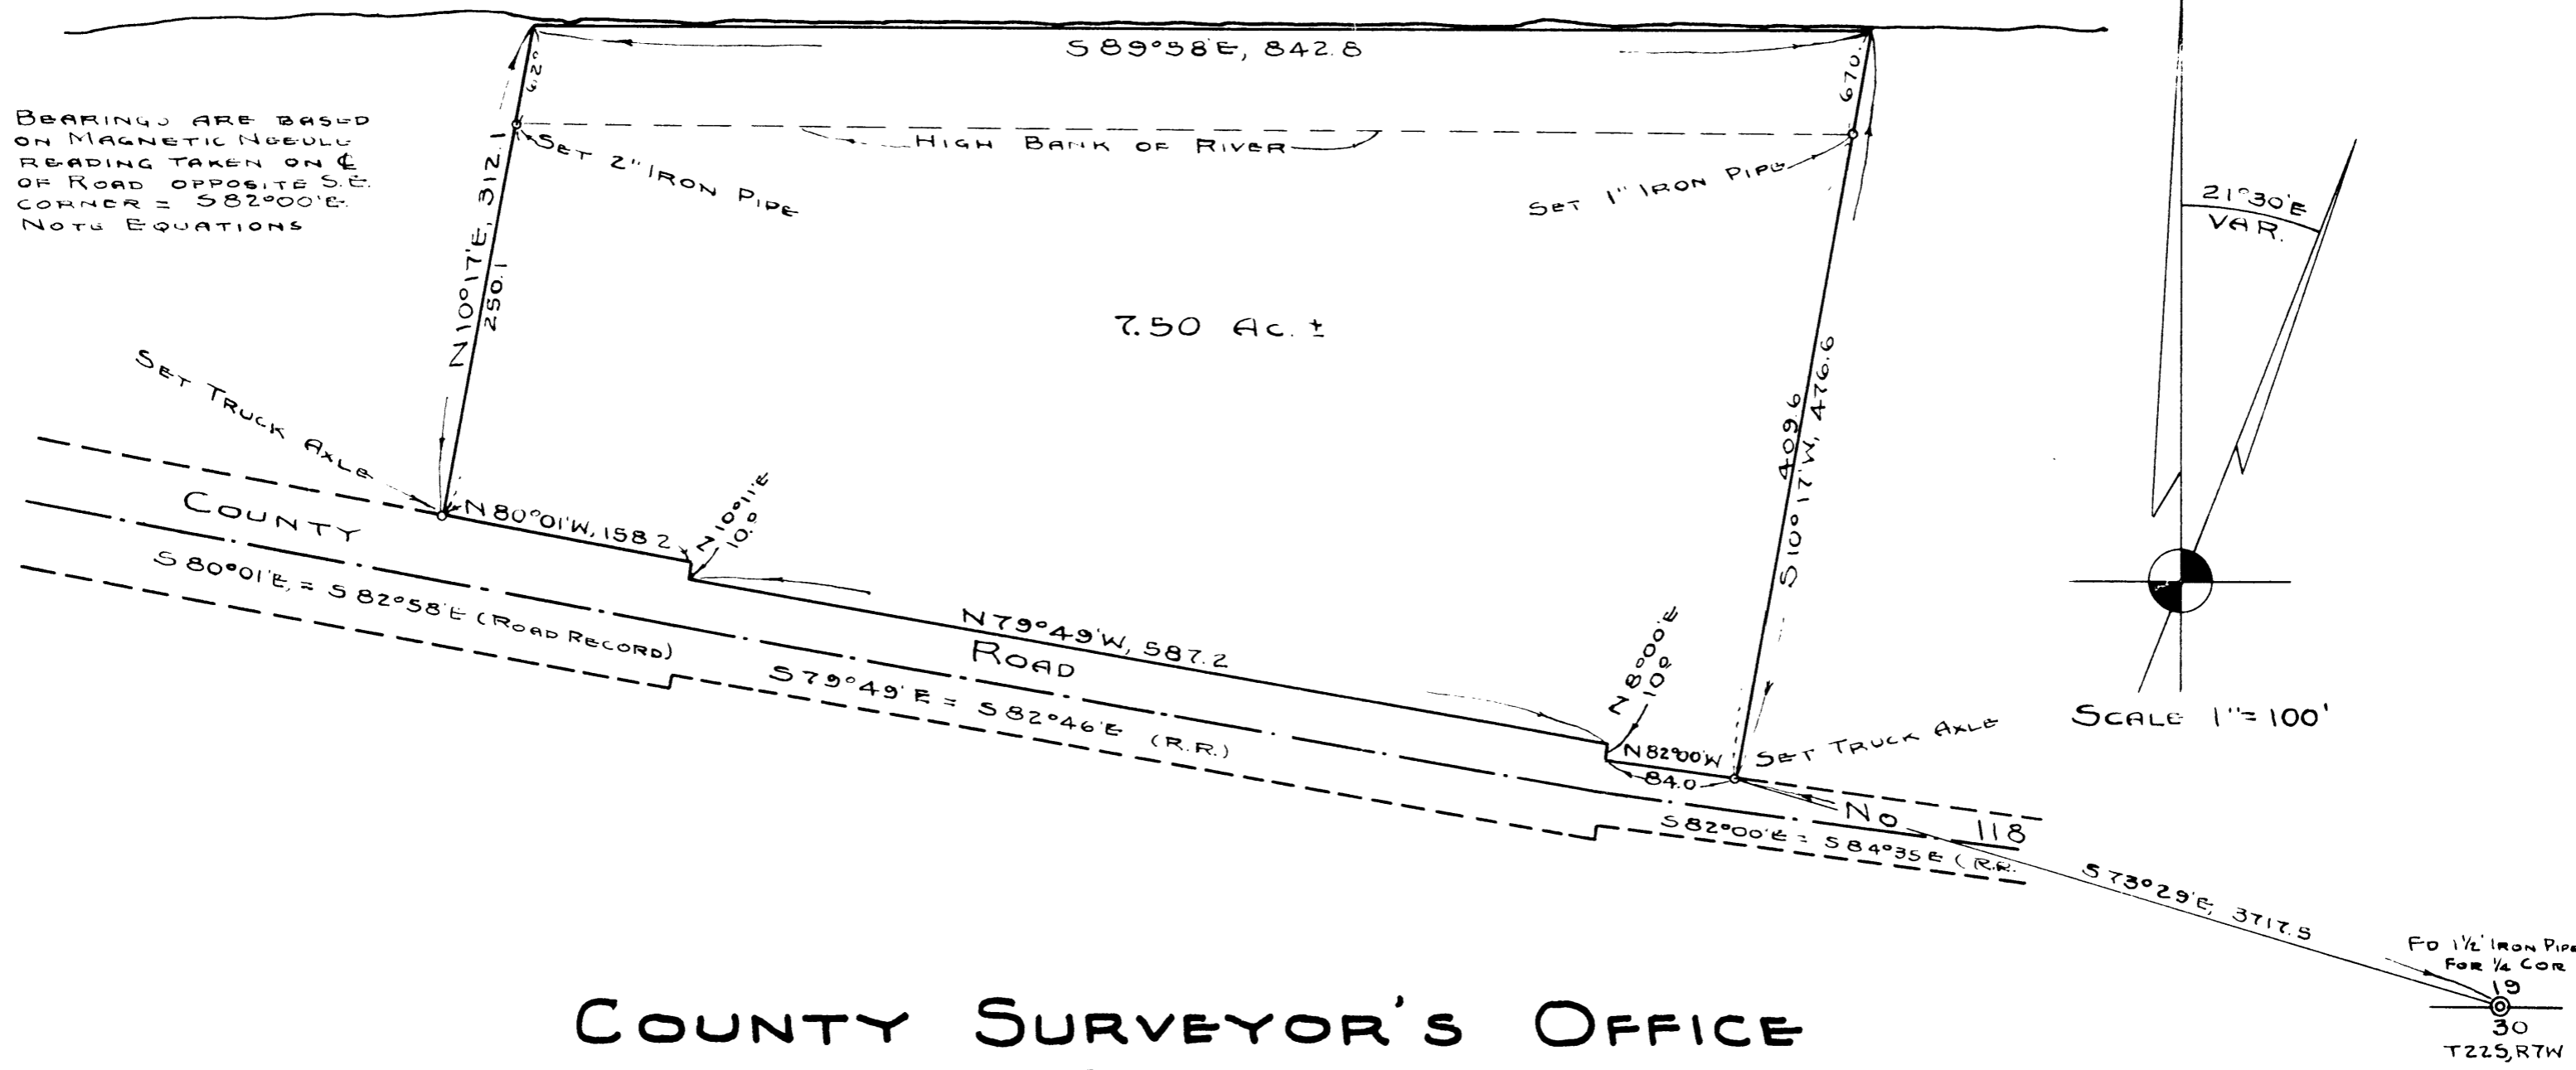

COUNTY SURVEYOR'S OFFICE DOUGLAS COUNTY OREGON SURVEY FOR DEED DESCRIPTION IN SECTION 24, T22S., R8W., WM.

BEN B. IRVING COUNTY SURVEYOR
 SURVEYED, JANUARY, 1951, BY
 N.E. RICHARDSON DEPUTY

CS FILE FOLDER

CONTAINS

MORE

INFORMATION