


44/111

Geo. J. Wundersott

COUNTY SURVEYOR'S OFFICE
DOUGLAS COUNTY, OREGON.
Surveys in
SECTION 24 T. 30 S. R. 4 W. W.M.
April 1951

COUNTY SURVEYORS FILE DATA
DO NOT REMOVE FROM OFFICE

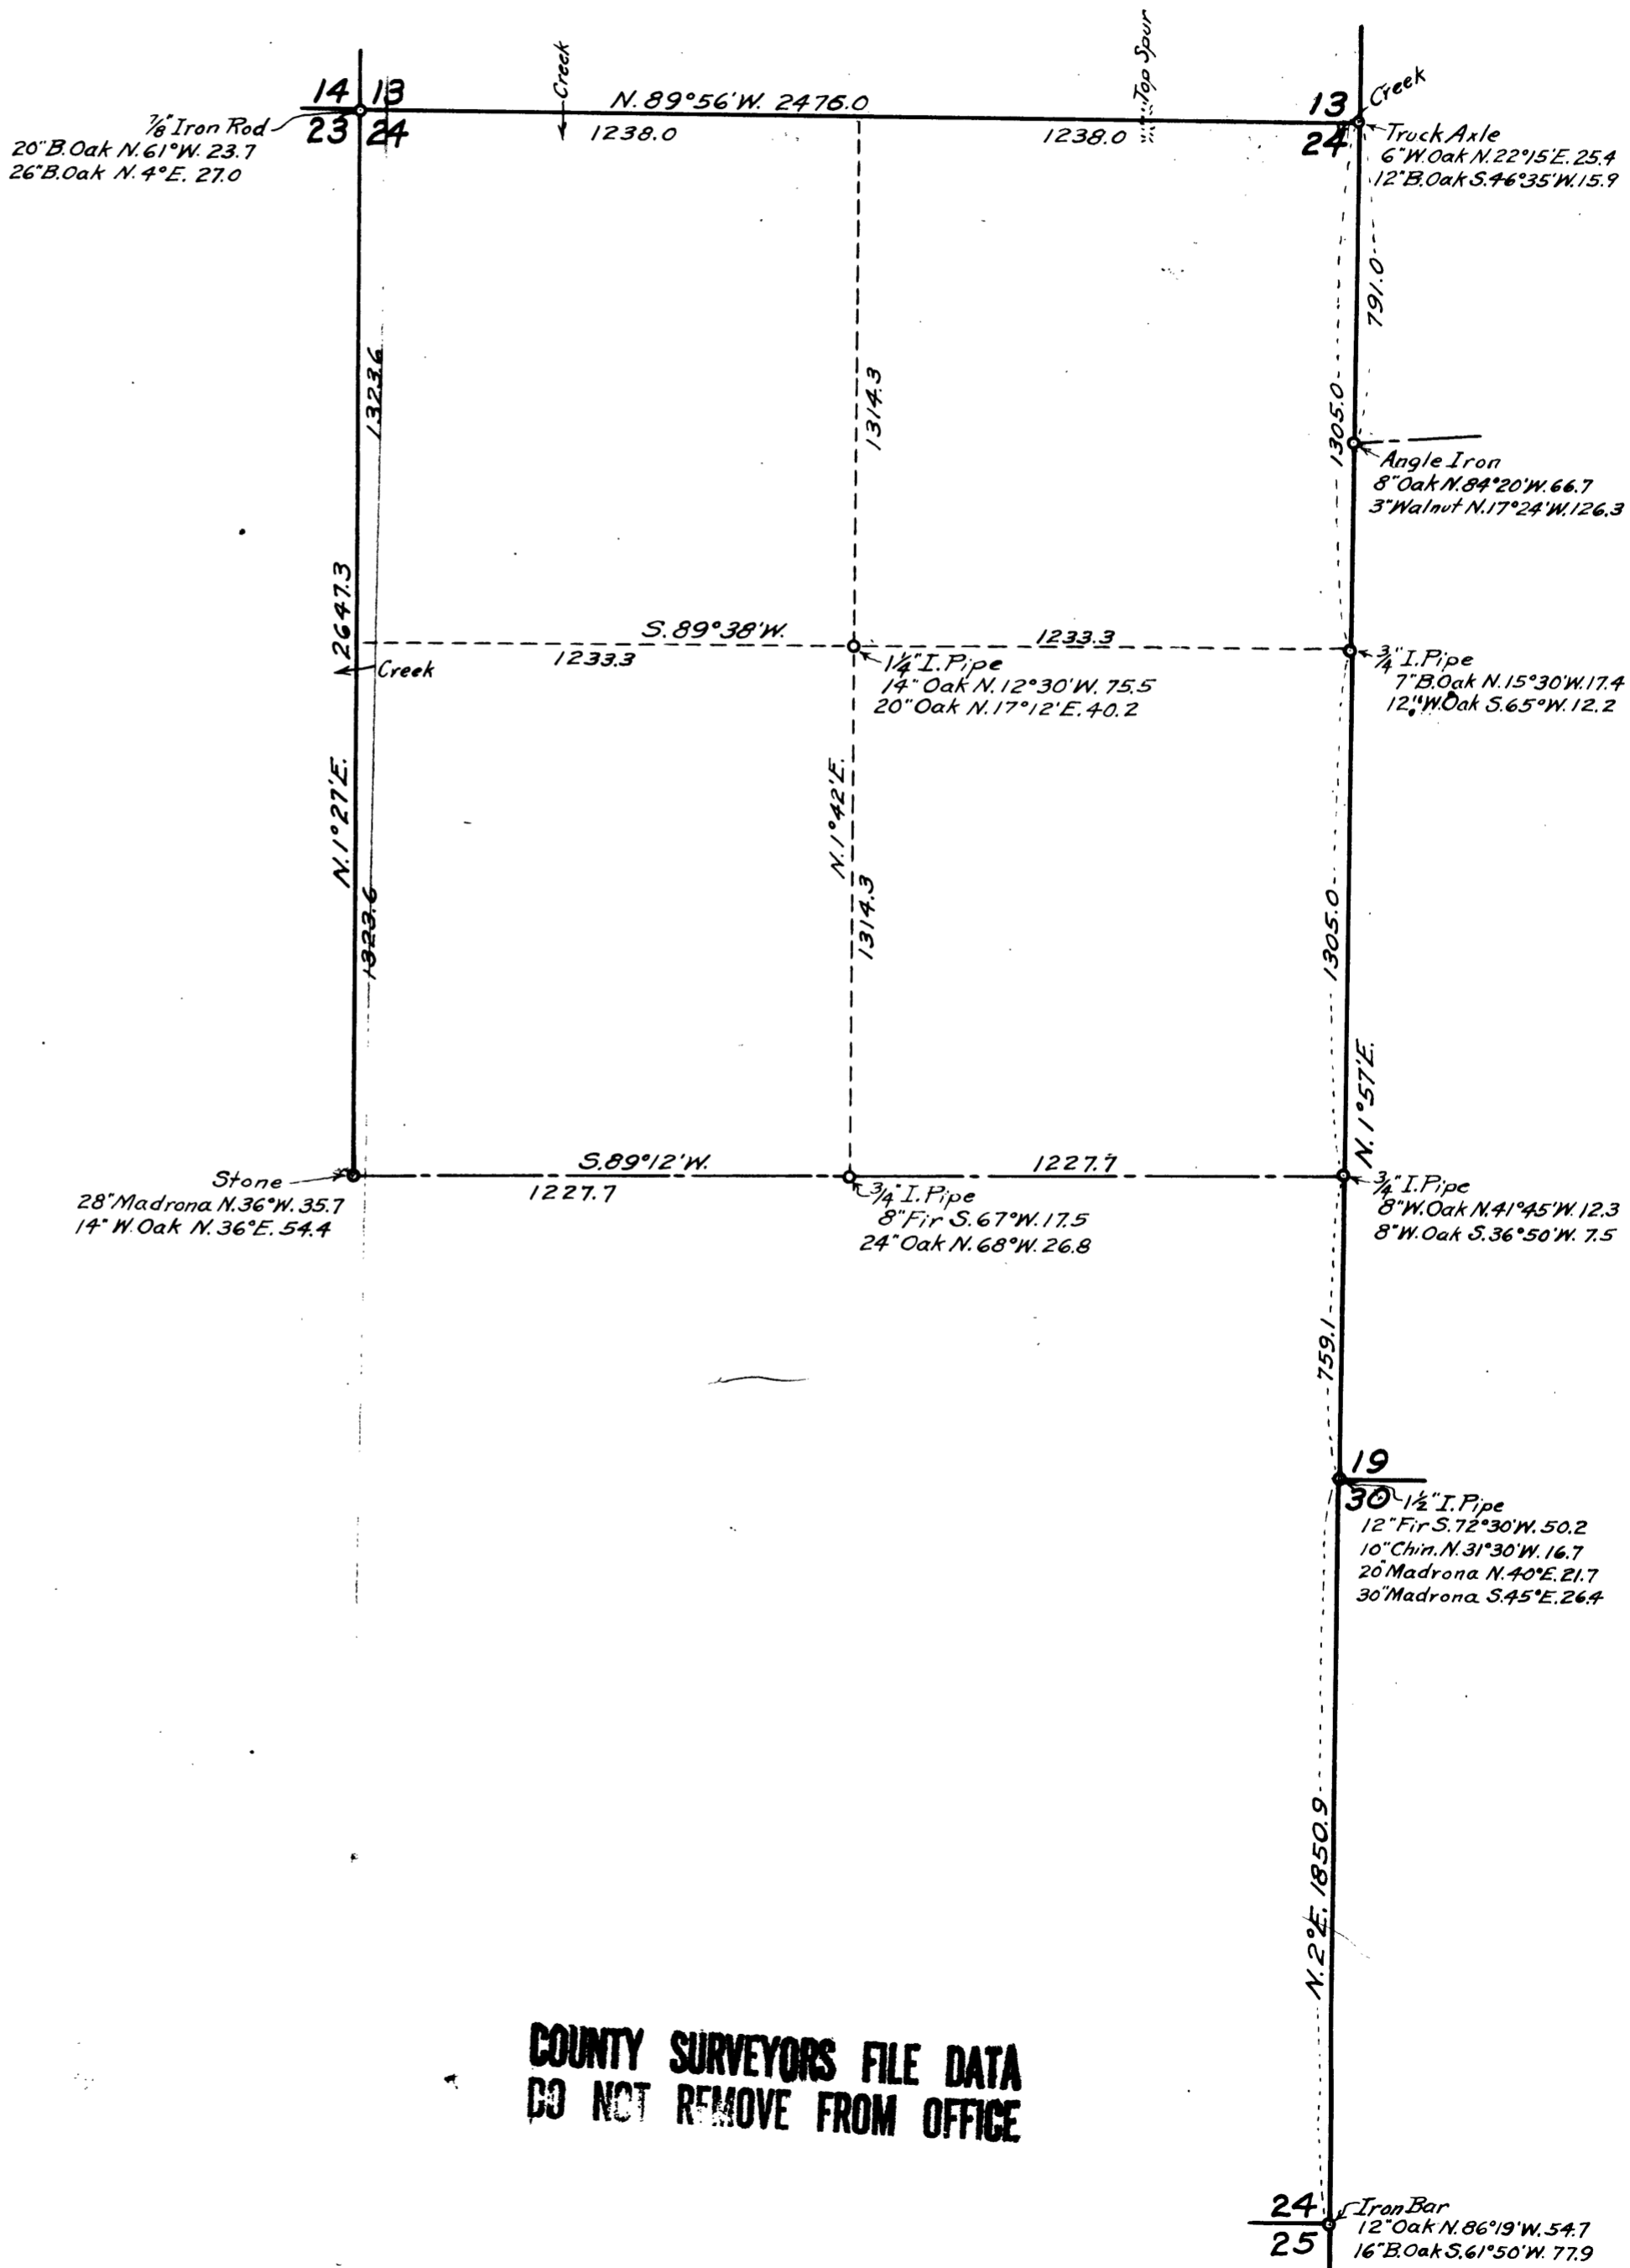

COUNTY SURVEYORS FILE DATA
DO NOT REMOVE FROM OFFICE

COUNTY SURVEYORS FILE DATA
DO NOT REMOVE FROM OFFICE