


COUNTY SURVEYOR'S OFFICE
DOUGLAS COUNTY, OREGON
Surveys in
SECTION 18. T.30S., R.3W., W.M.
Aug. 1950

REGISTERED
OREGON
LAND SURVEYOR
Geo. J. Wendert
MA 23 344
1948

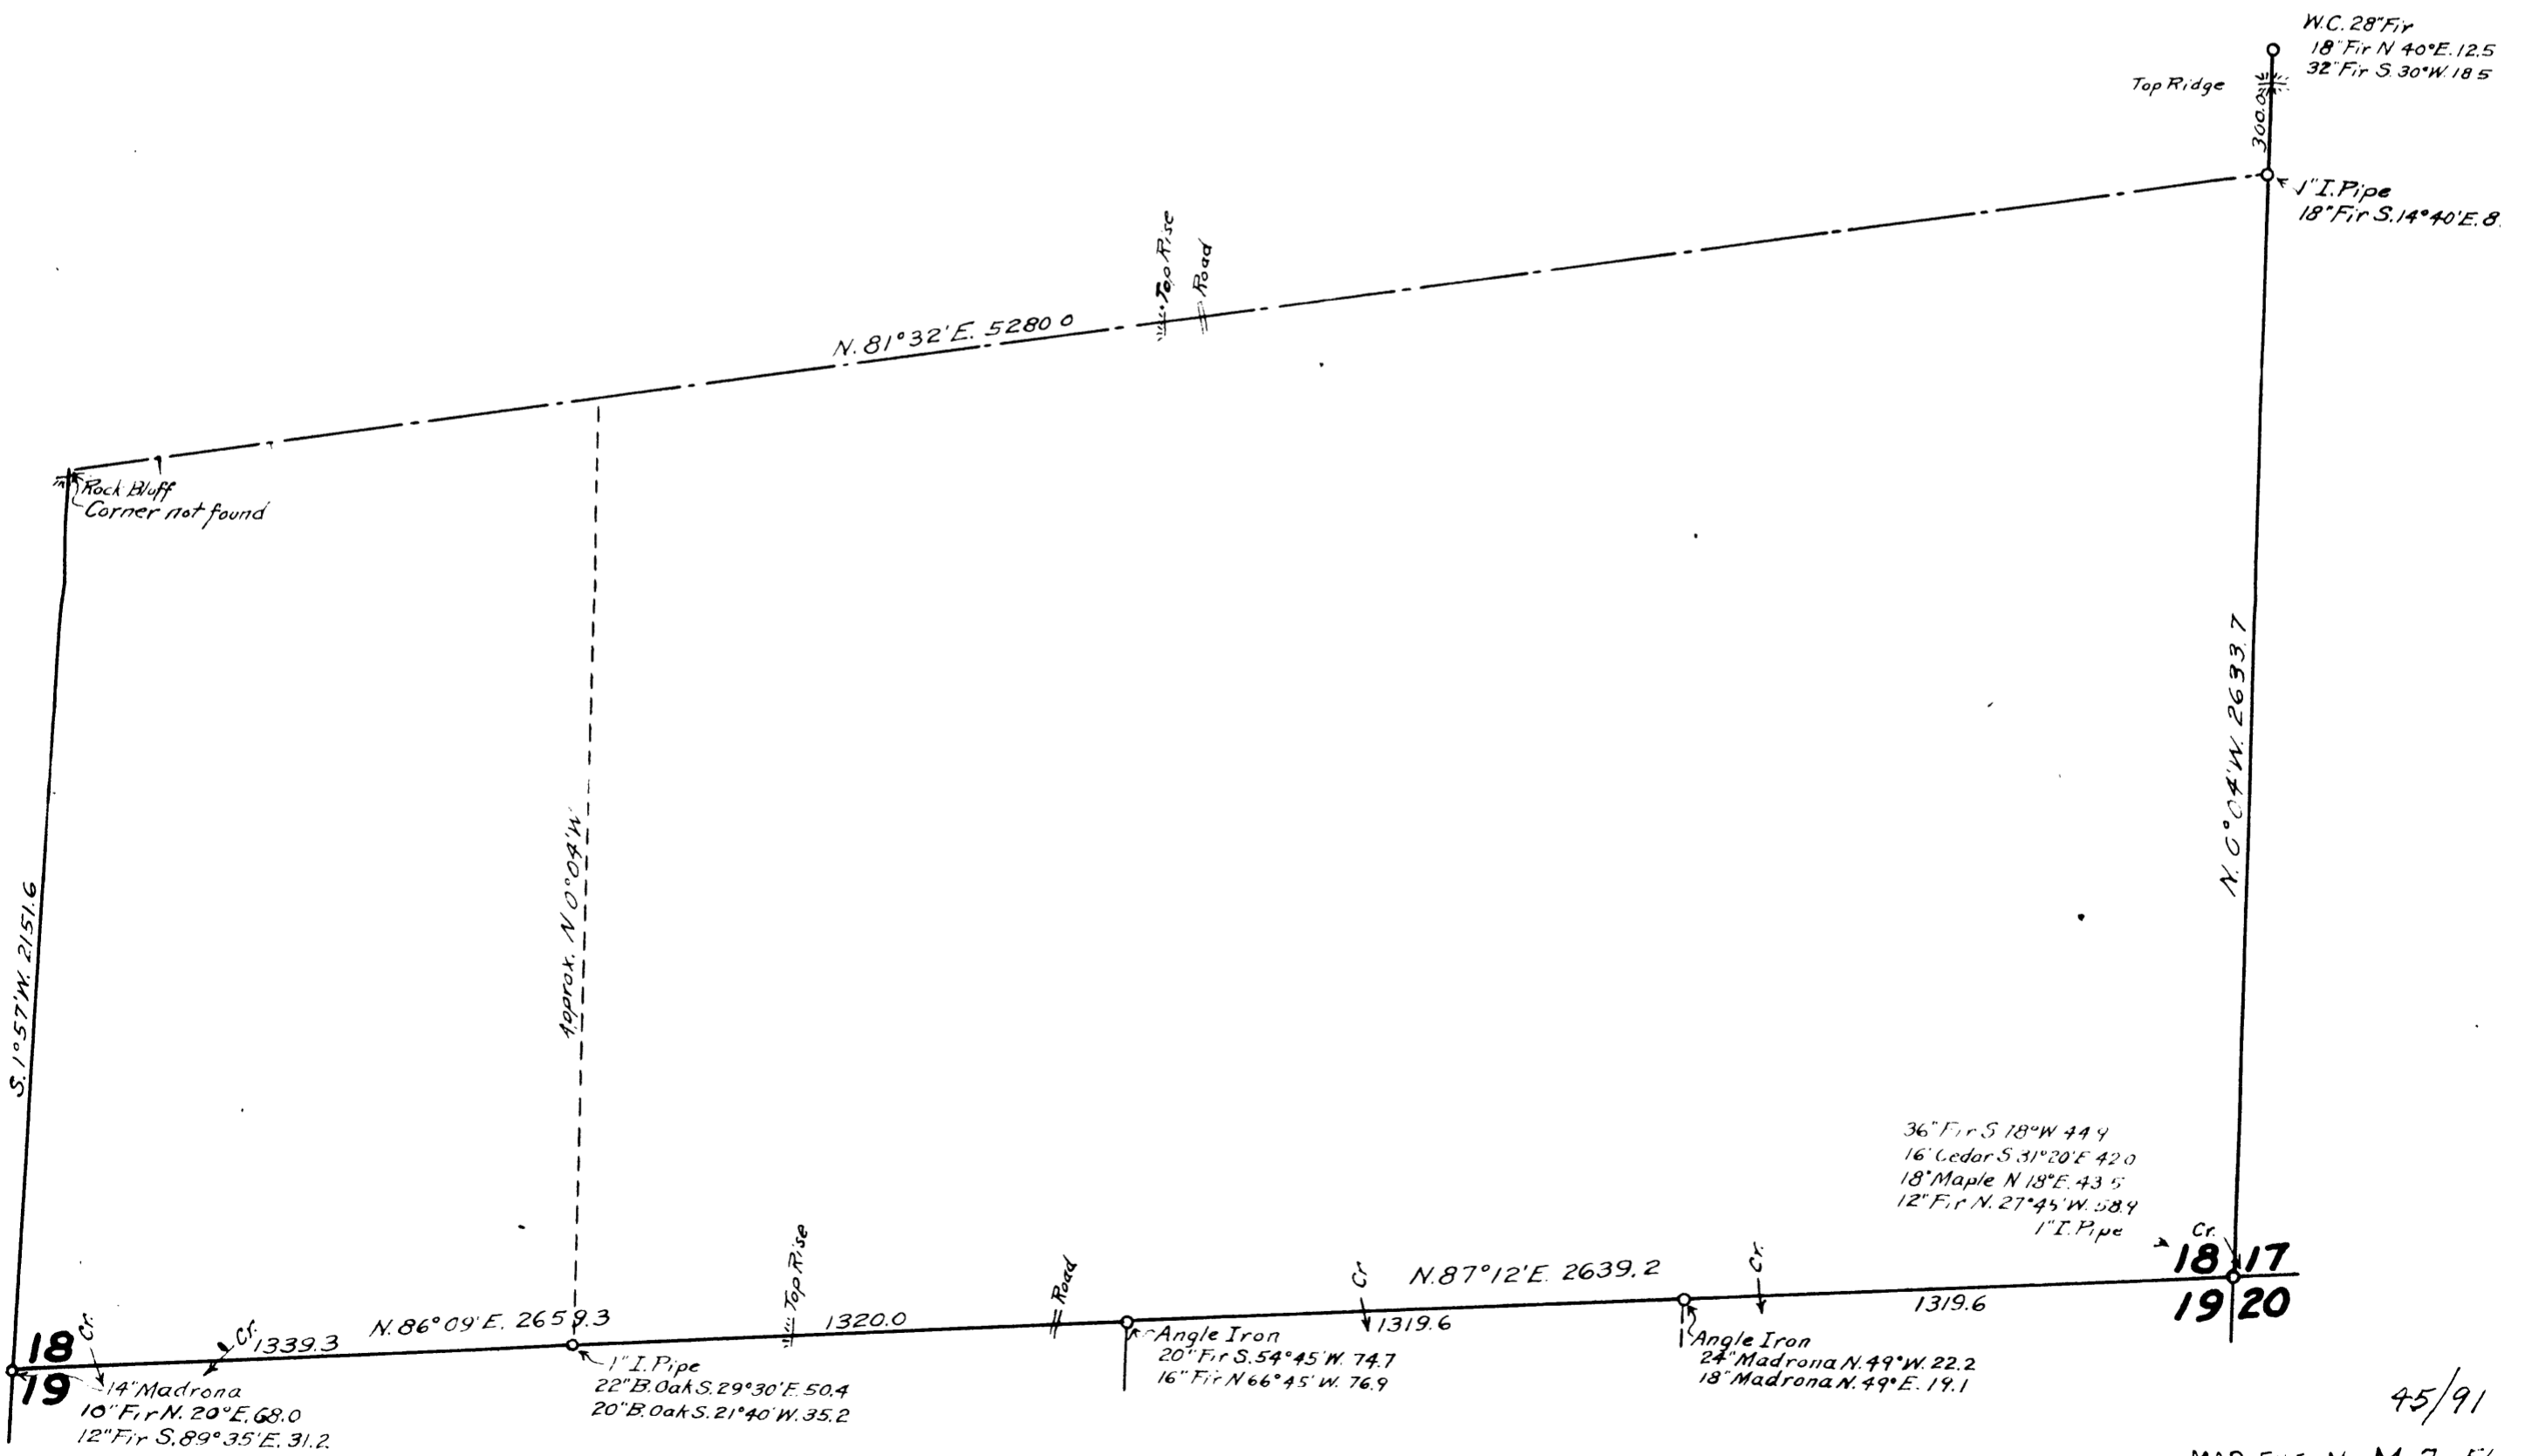

45/91

MAP FILE No. M 7-56