


* AREA BEING IRRIGATED UNDER PERMIT NO. 13330

I, BEN. B. IRVING, OF ROSEBURG, OREGON DO HEREBY CERTIFY THAT THIS MAP WAS MADE FROM NOTES TAKEN DURING AN ACTUAL SURVEY MADE BY ME IN NOV. 1952, AND FROM DATA SHOWN IN PERMIT NO. 13330; THAT THE MONUMENT SHOWN ON THE SOUTH UMPQUA RIVER IS THE DISTANCE SHOWN, FROM THE CORNER TO SECS. 7, 17, & 18, T29S, R5W, W.M.

Ben B. Irving
 BEN. B. IRVING
 Co. SURVEYOR

SCALE 8" = 1 MILE

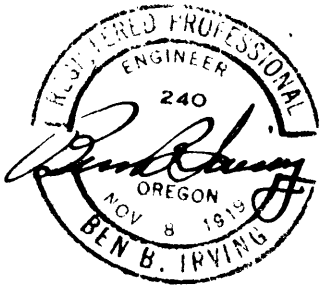

WATER RIGHT
 FOR
 W. A. BLACKERT
 SECTIONS 7, 18, T29S., R5W., W.M.

OFFICE OF
 BEN. B. IRVING
 COUNTY SURVEYOR, DOUGLAS COUNTY.
 ROSEBURG, OREGON

45/121