


REGISTERED
OREGON
LAND SURVEYOR

Geo. J. Wenderoth

MARCH 10, 1944
George J. Wenderoth
5

**COUNTY SURVEYORS FILE DATA
DO NOT REMOVE FROM OFFICE**

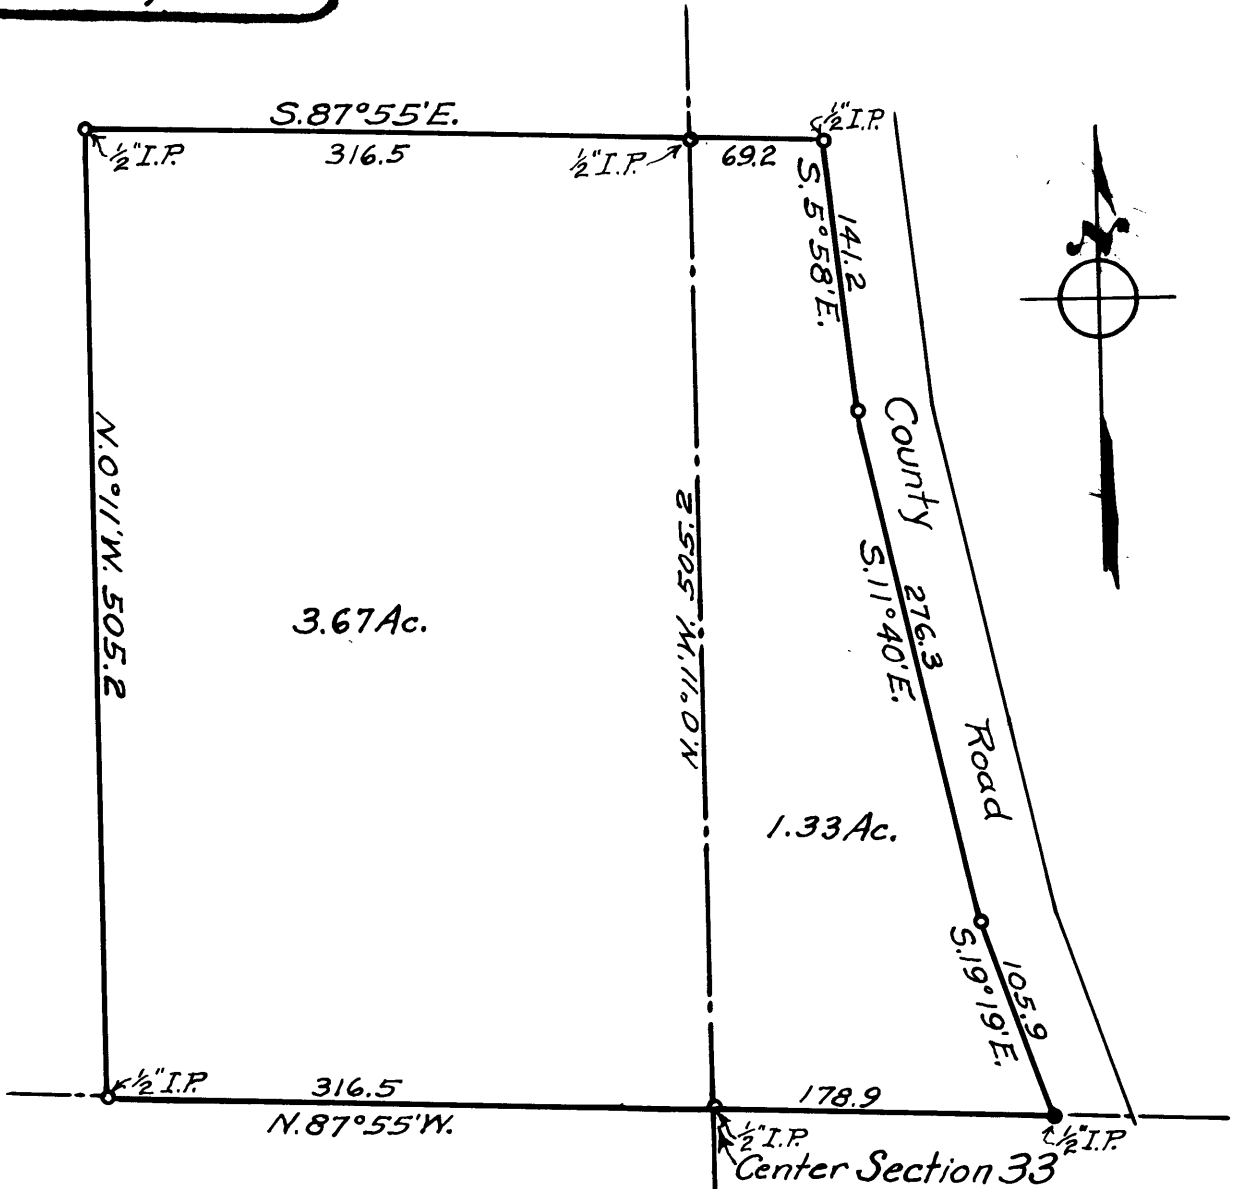

**COUNTY SURVEYORS OFFICE
DOUGLAS COUNTY, OREGON.**
Survey For
D. D. CHAMBERS in
Section 33 T. 31 S., R. 4 W., W. M.
G. J. Wenderoth, deputy.
Dec. 1952 Scale 1" = 100ft.

45/124
95/124