


**COUNTY SURVEYOR'S OFFICE
DOUGLAS COUNTY, OREGON
Surveys in
SECTION 33, T.31S., R.4W.W.M.**

REGISTERED
OREGON
LAND SURVEYOR
Geo. J. Wanders

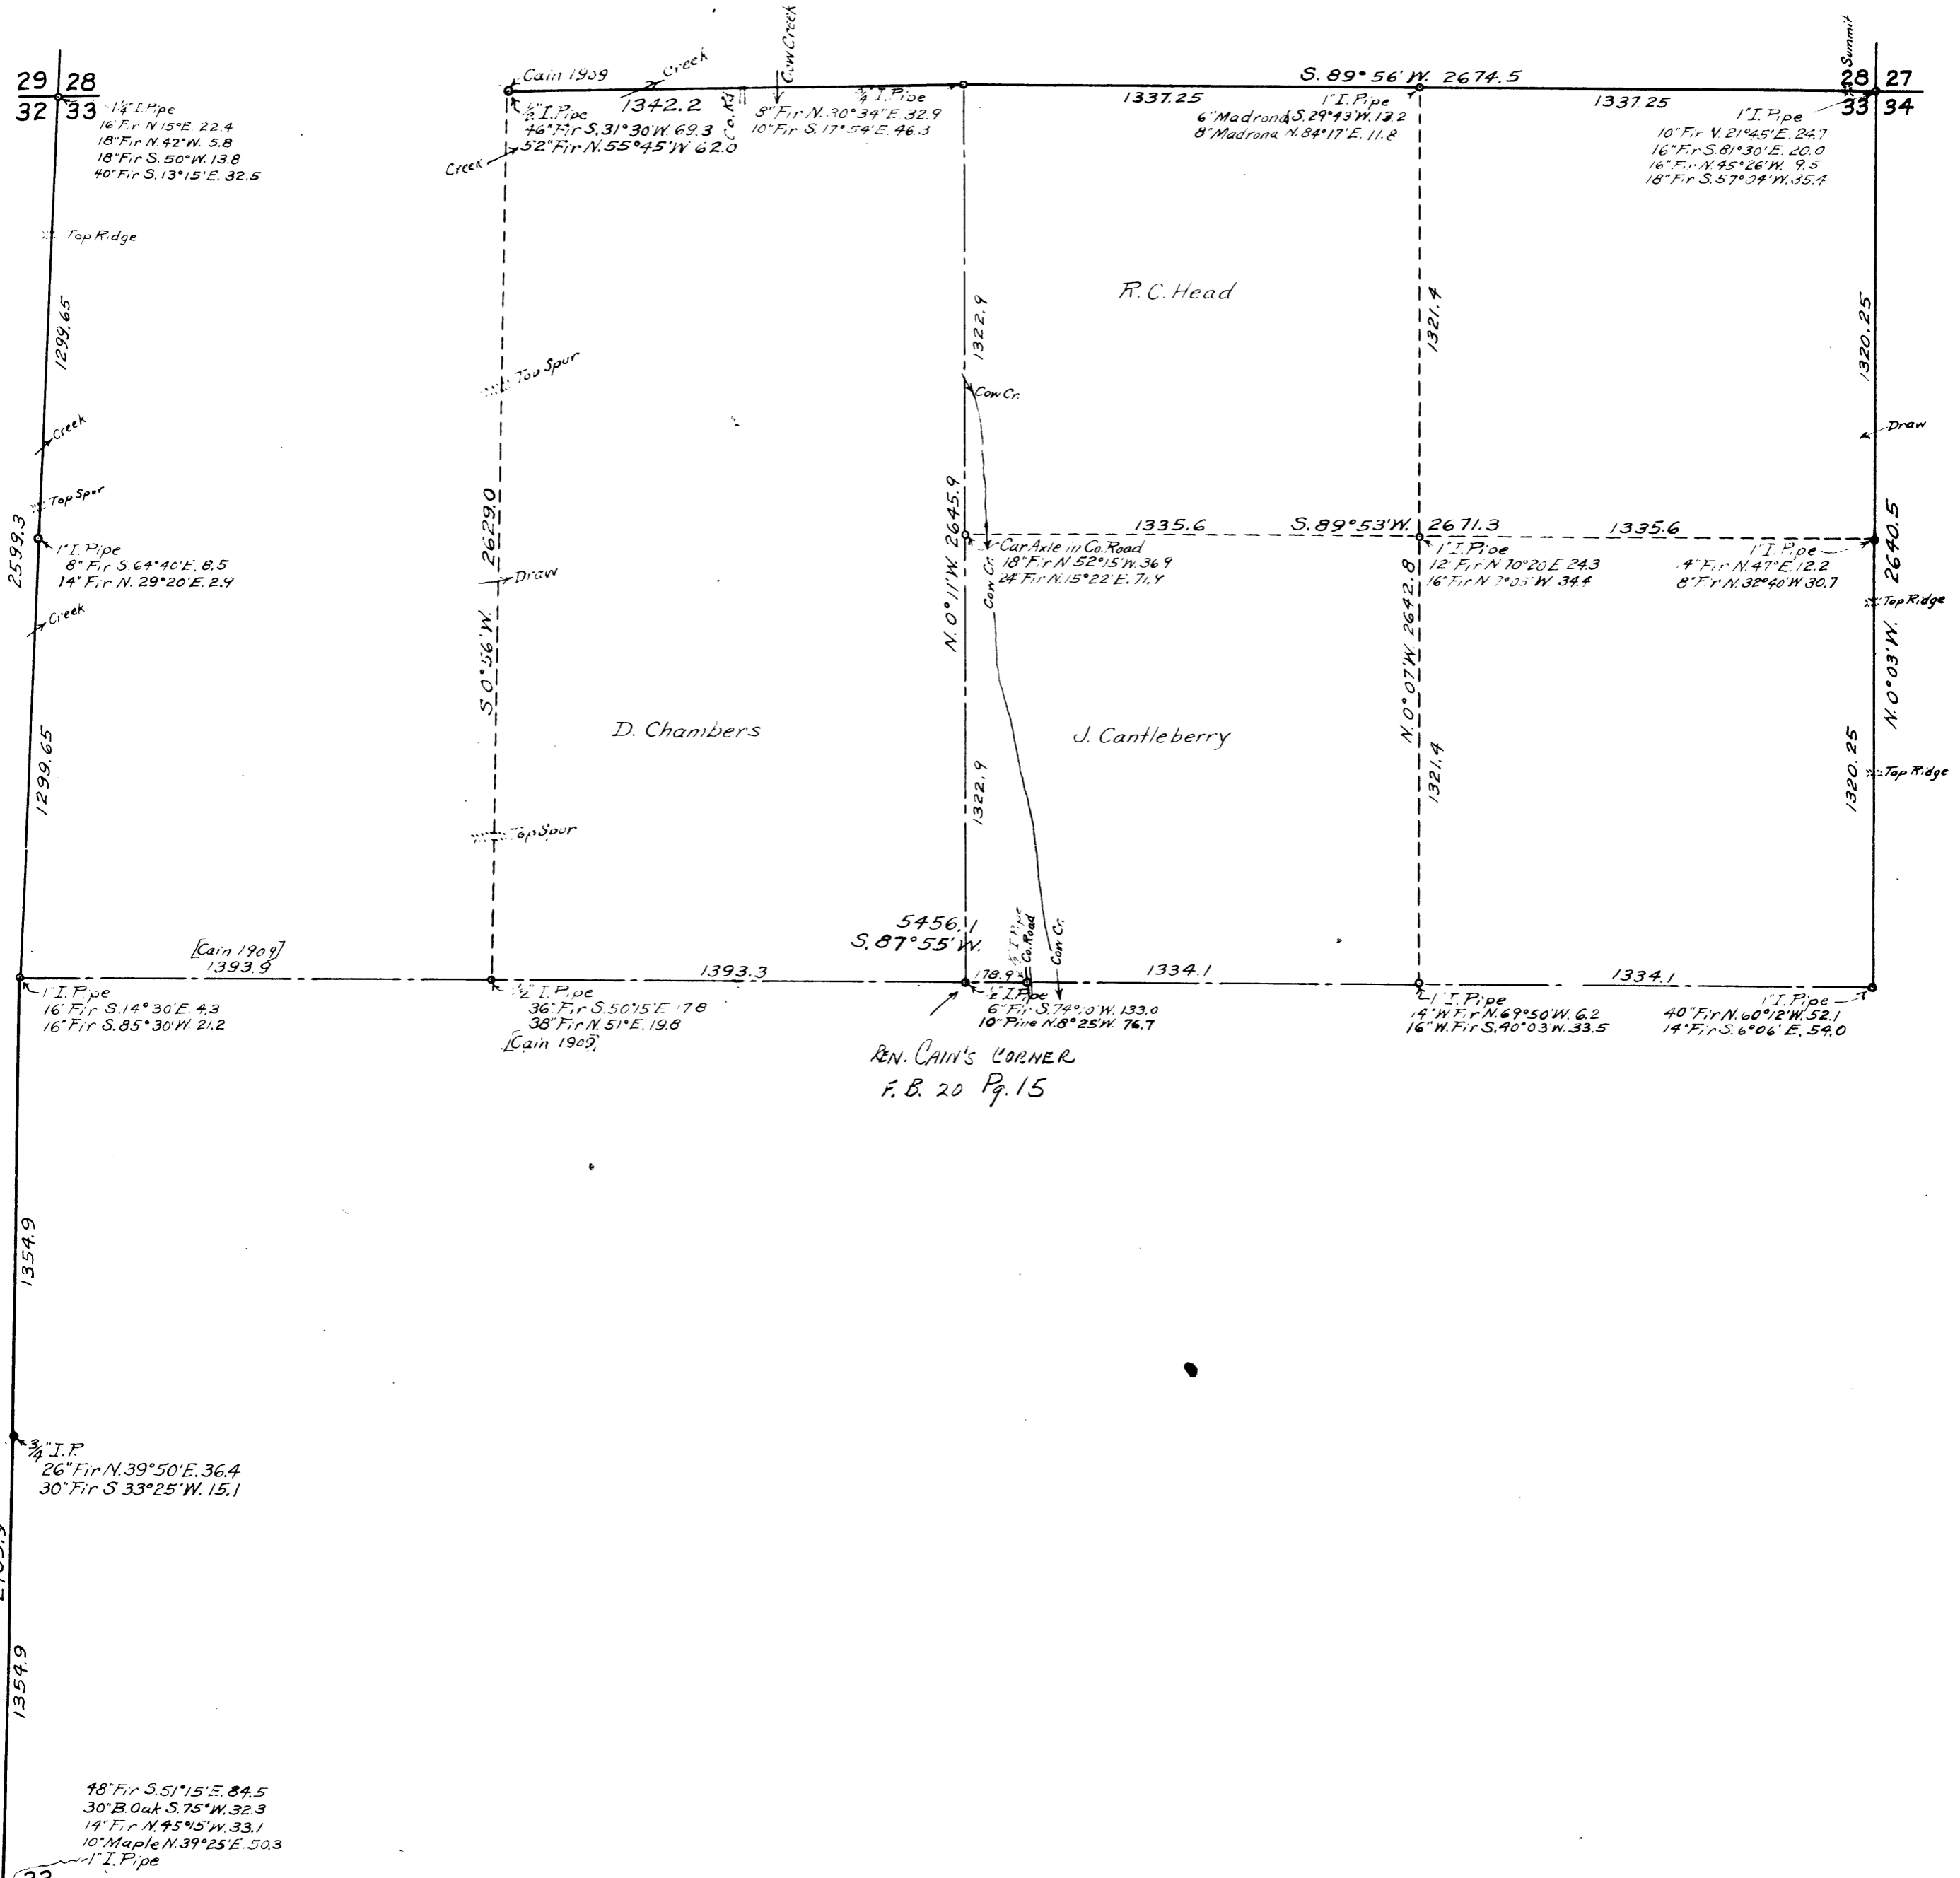

DATED 1953

45/225