


1945
1948
1953

COUNTY SURVEYOR'S OFFICE
DOUGLAS COUNTY, OREGON.
SURVEY'S IN
SECTION 26, T.32 S., R. 5 W., W.M.
Geo. J. Wenderoth, deputy

REGISTERED
OREGON
LAND SURVEYOR
Geo. J. Wenderoth
MARCH 16, 1944
George J. Wenderoth
5

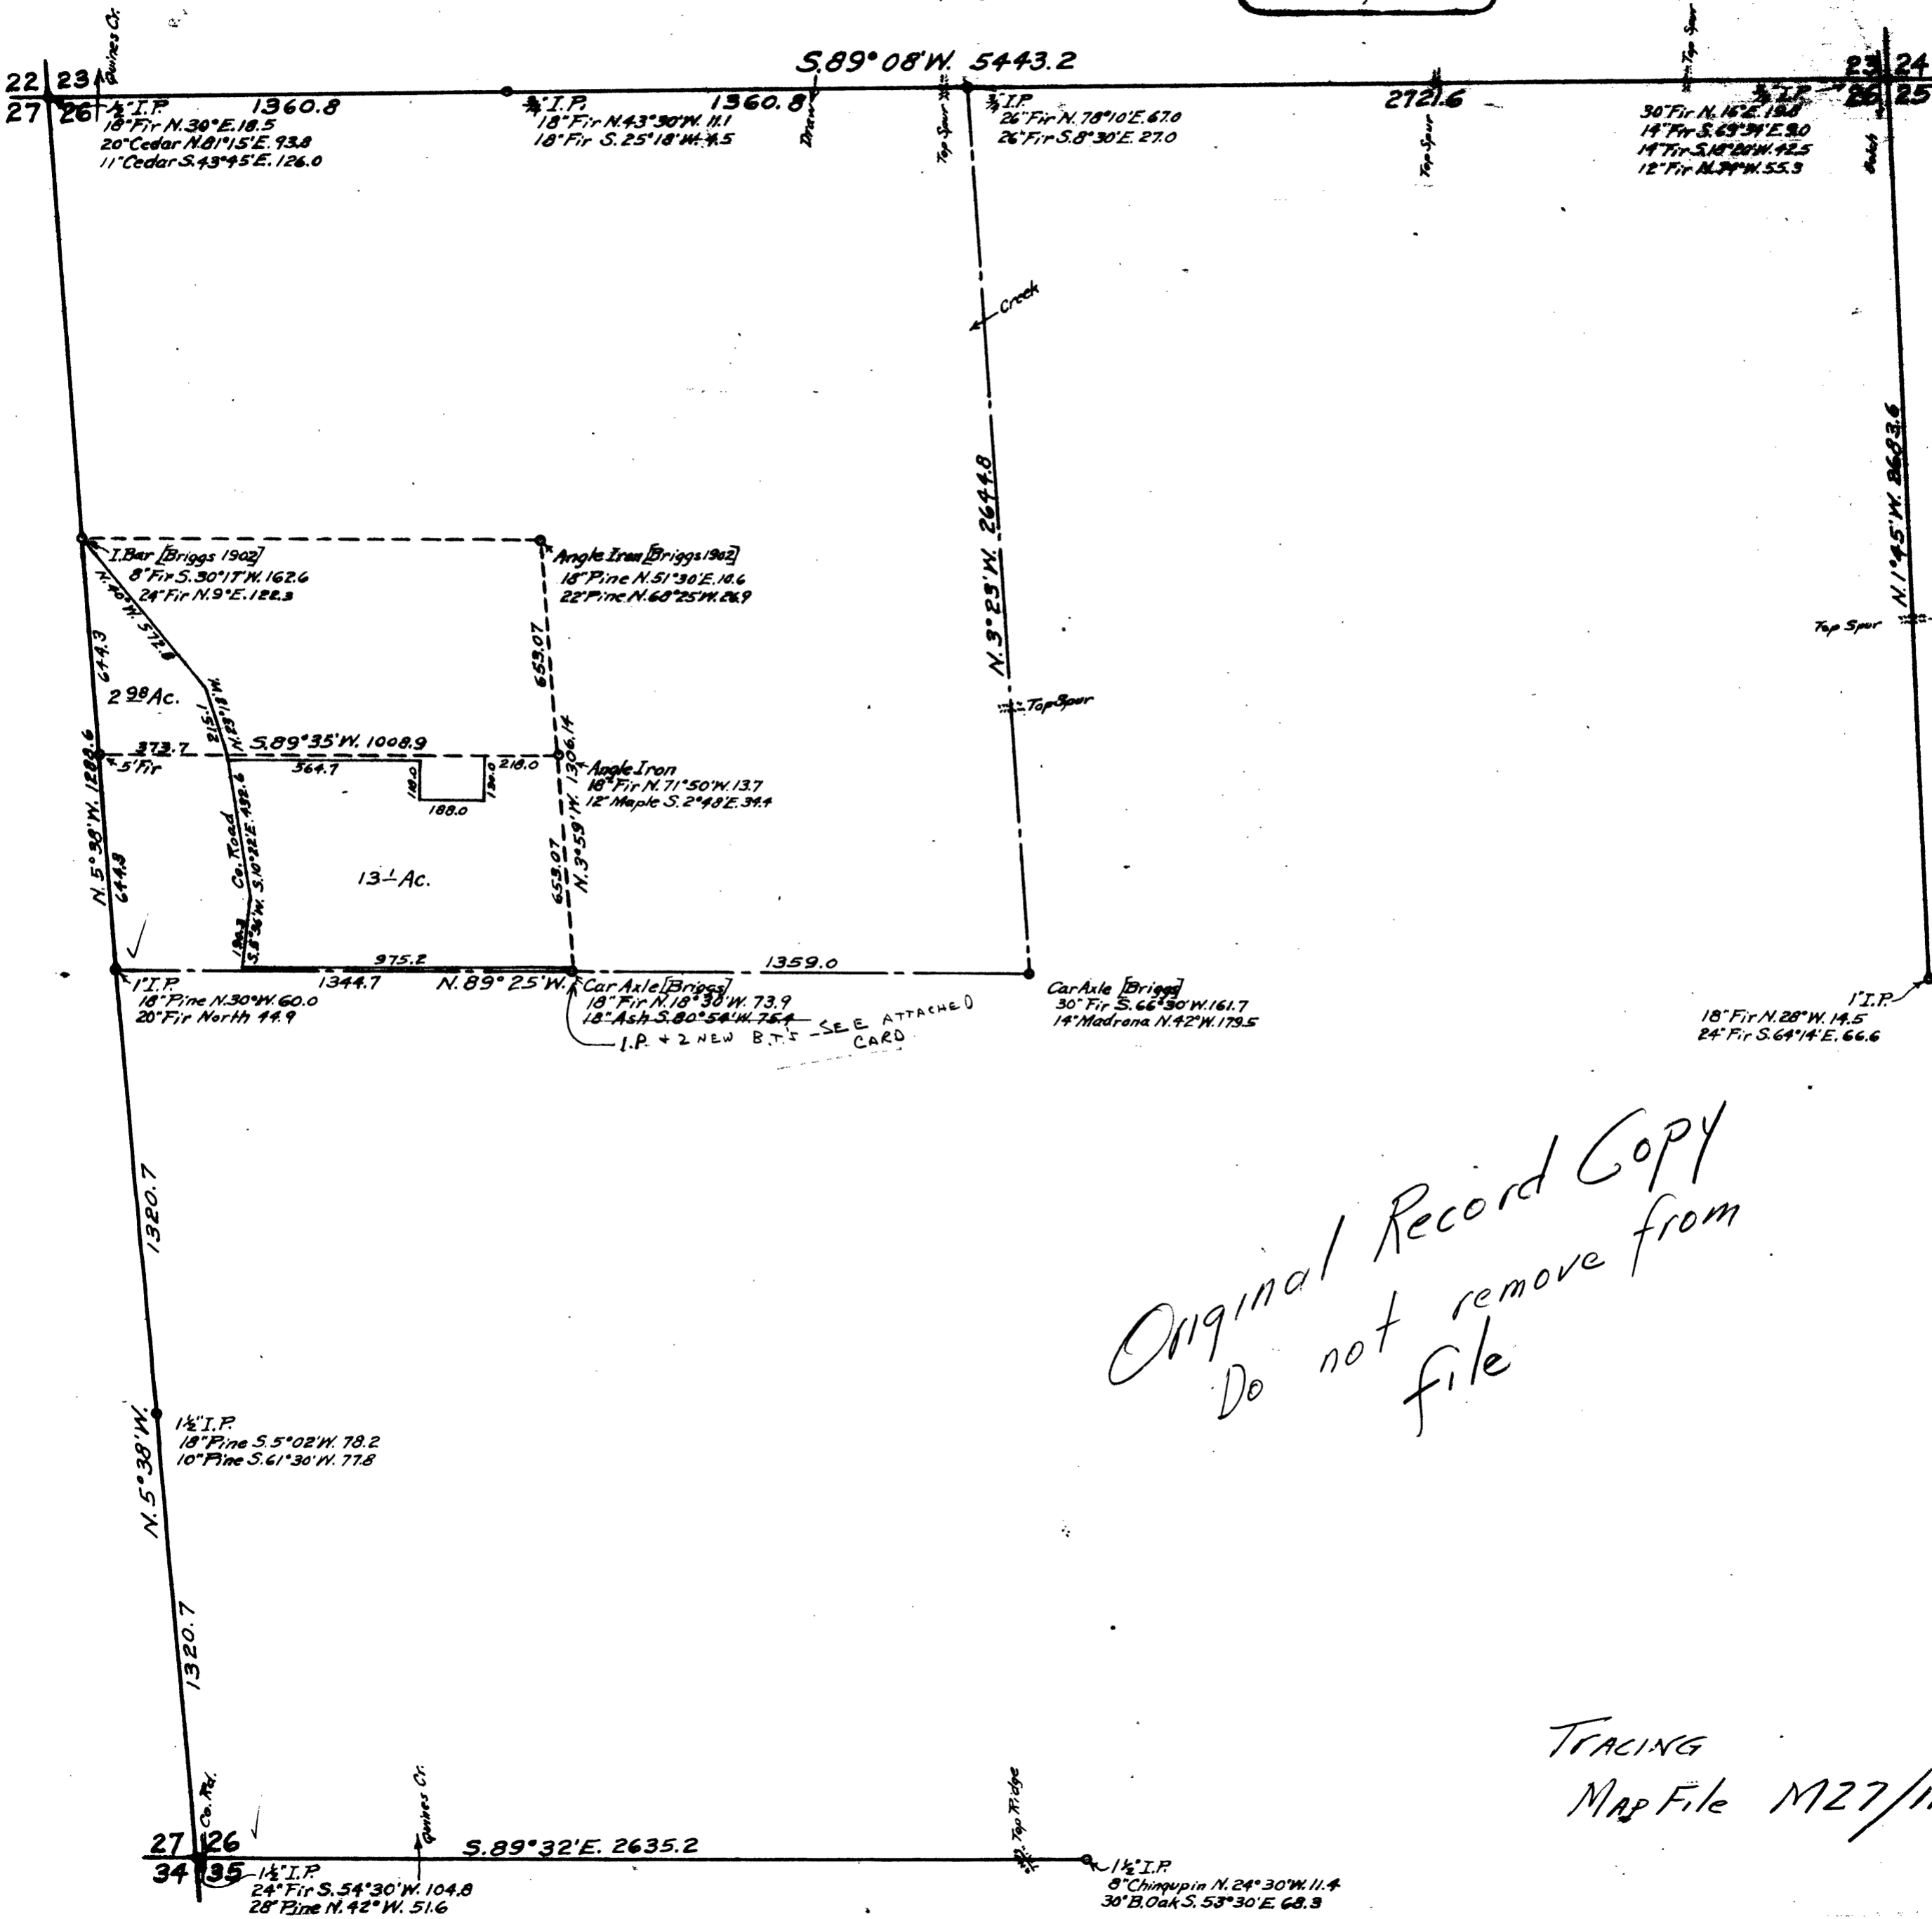

Original Record Copy
Do not remove from
file

TRACING
MAP File M27/11