



REVISED 2-64
R. IRVING

RENEW WEST 1/4 COR
SEC 21 T29S R8W

FOUND - GEARED AXLE
AND OLD BT 30" FIR S 20° E
16 LKS. IN GOOD CONDITION.

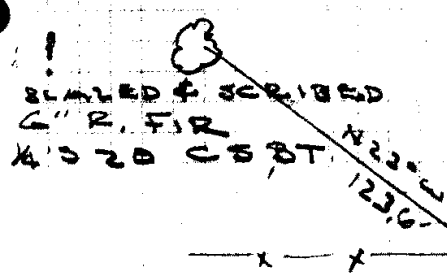

BLAZED & SCRIBED
8" R. FIR
40 21 CS BT

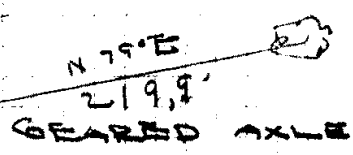

YAR, 21 1/4'