


BALLE PLACT

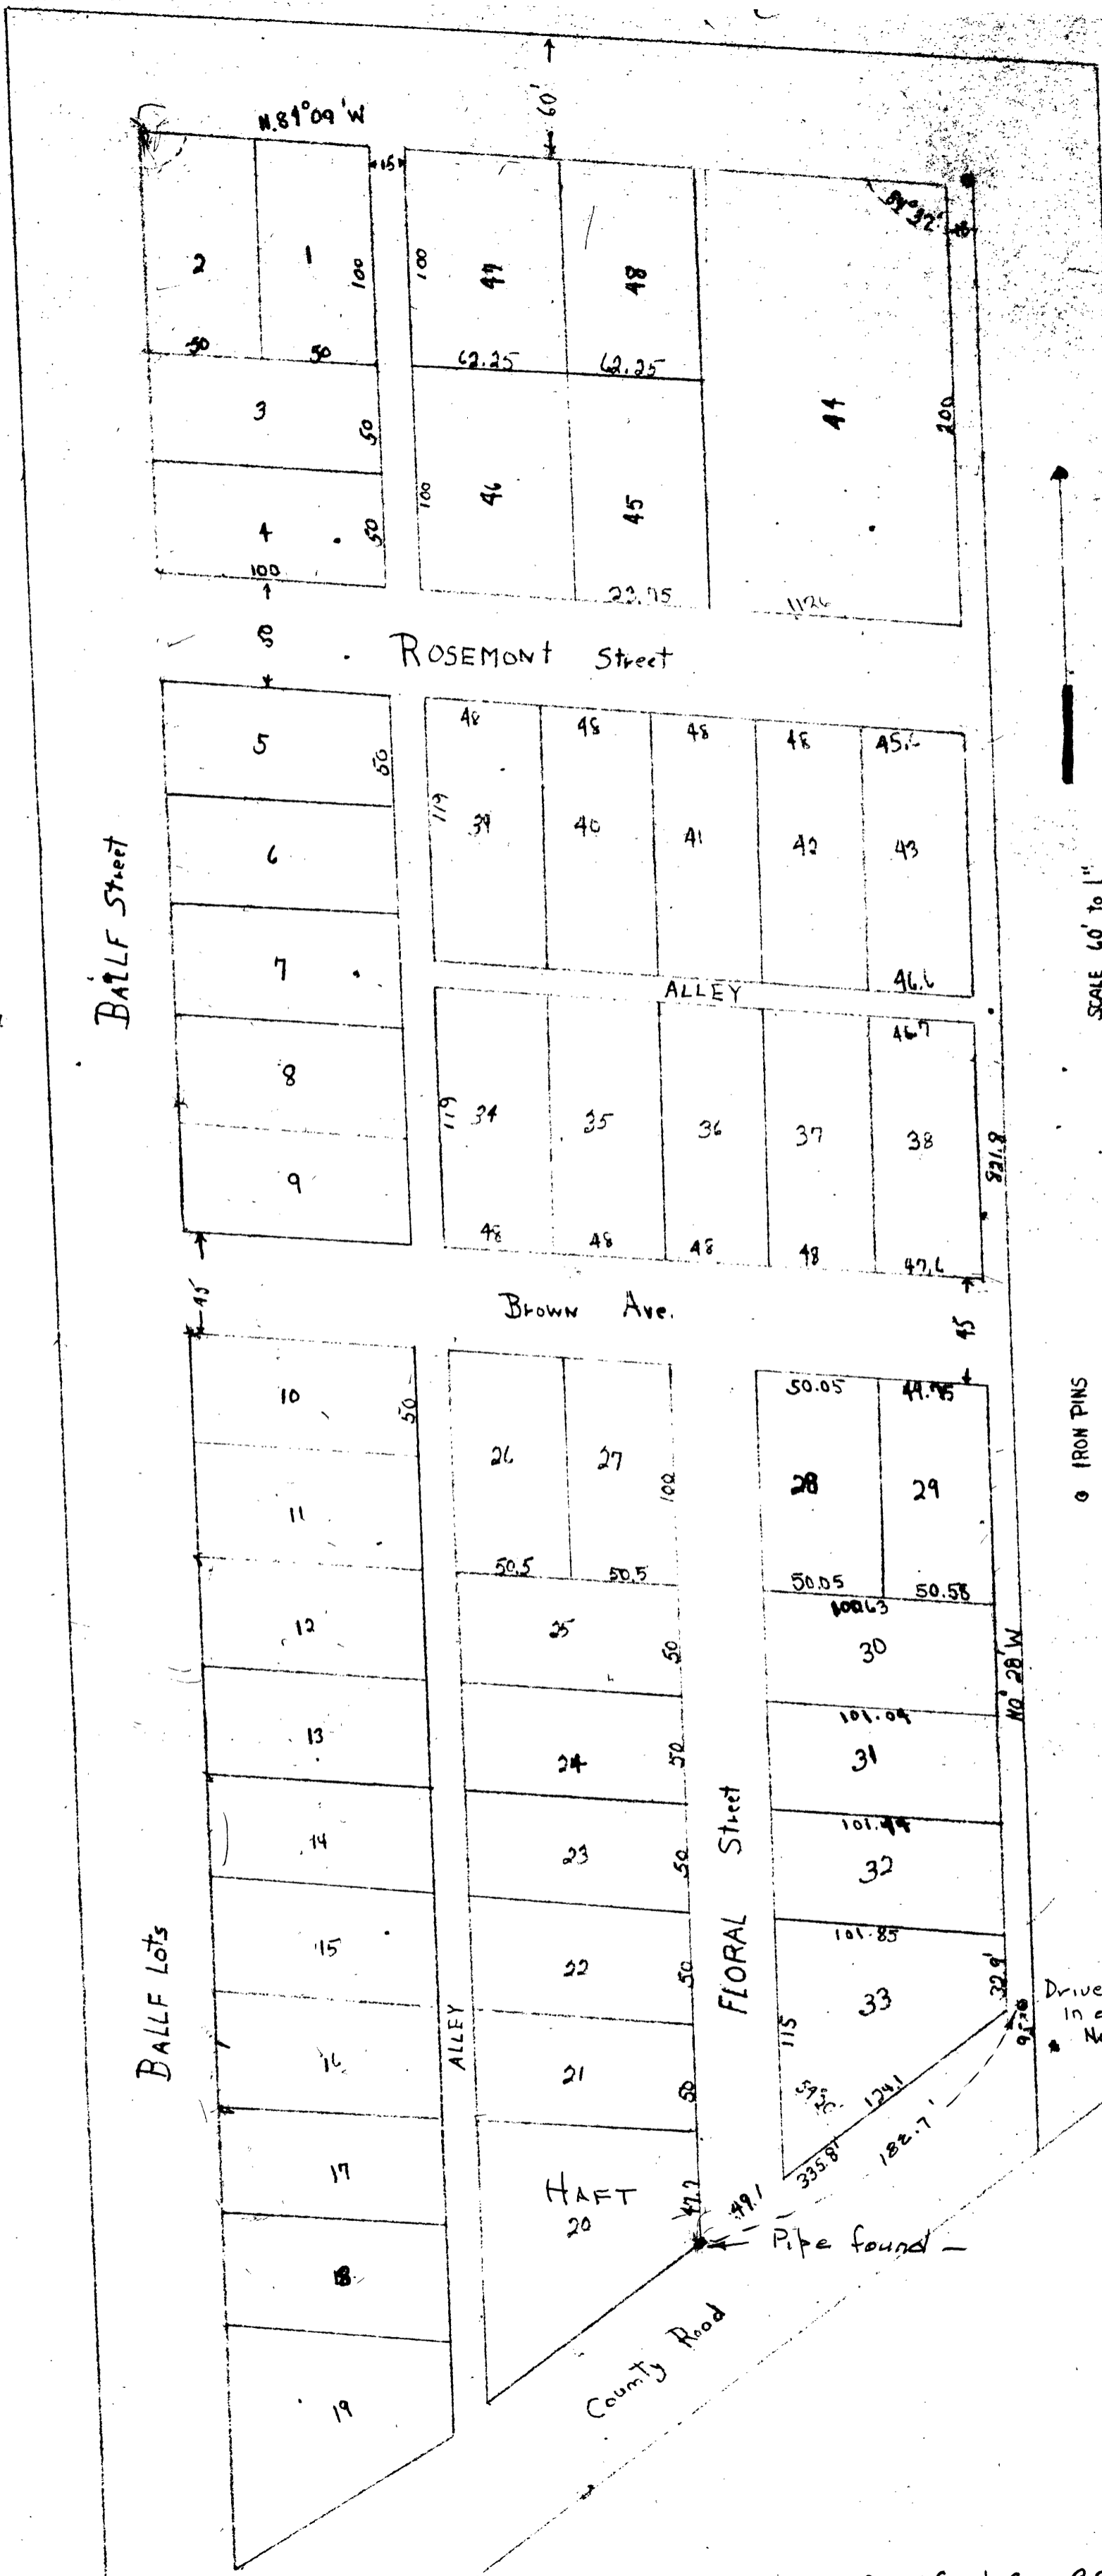

850
50
145
125

BALLE Street

BALLE Lots

ROSEMONT Street

BROWN Ave.

FLORAL Street

COUNTY ROAD

SCALE 60 to 1"

IRON PINS

Drive 24" x 7/8 Rod
In old rotted post stump
Near Whites Fc Cor.