

Relocation 1/2 Cor

T 23-9

3-3-54



B. Paulin

M. Skelton

D. Garrett

B. Stringer

1/4 | 16
21 | Cor

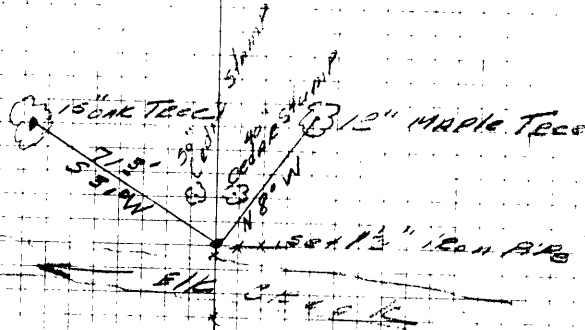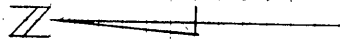

Douglas County Rd #7

O.K.
F. C. [Signature]

C. S. File No. 46/56