

*J. Z. Dillard*

DOUGLAS ST. (Macadam)

Grade Xing

SOUTHERN PACIFIC R.R.

2 1/2

STREET VACATED

WASHINGTON ST.


ST. (Concrete Pvg)

ST. (Concrete Pvg)

ST.

STEPHENS

PACIFIC HIGHWAY

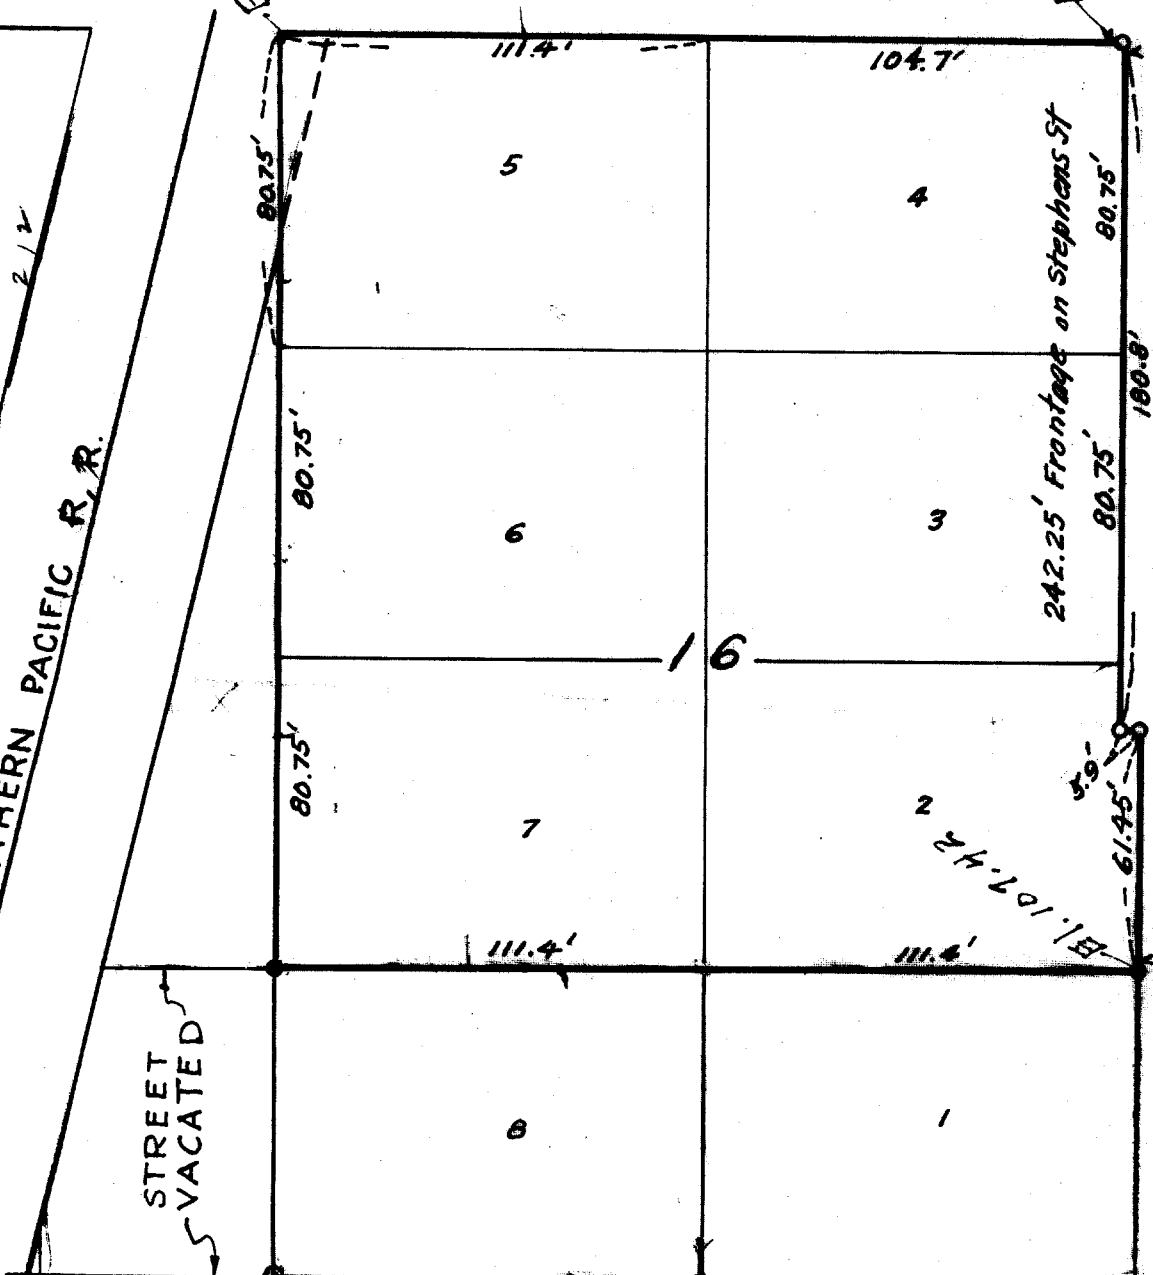

LOTS 2 TO 7 incl. for consideration.

COUNTY SURVEYORS FILE DATA  
DO NOT REMOVE FROM OFFICE

COUNTY SURVEYOR'S OFFICE, ROSEBURG, ORE.  
BLOCK 16 ROSEBURG,  
DOUGLAS COUNTY, ORE.  
NOV. 1943. - Boyer, Dep. SCALE, 1" = 50 FT.

T.27-5 S.19 NW 1/4

P COUNTY SUR. FILE 46/59-1

CS FILE FOLDER

CONTAINS

MORE

INFORMATION