

RENEW 1/4 COR. 18/17  
T 29 R 5W

Nov. 22-54

J. BYRON

R. IRVING

J. FEE

~~FOUND - BOTH ORIG. BTS.  
CHECK RECORD DIST & BEARINGS~~

~~THE S.E. BT SCRIBED 1/4 BT~~

~~THE N.W. BT. ROTTED CENTER~~

BLAZED & SCRIBED 22" B.O.  
77.8' S 41° E 1/4 S 17 CS BT

BLAZED & SCRIBED 24" B.O.  
47.6' N 25° W 1/4 S 18 CS BT


1" P. WITH  
SET BRASS CAP FOR COR.

MND. COUNTY SURVEYORS OFFICE

T 29 S R 5W 1954 1/4 SEC

18/17 ON EAST WEST FENCE  
LINE.

FOUND - BOTH ORIG. BTS. THE  
S.E. BT CHECKS FOR BEARING &  
DIST. THE RECORDED N.E. BT.  
(N 18° E 80 LKS) FOUND TO BE N 18° W  
80 LKS, THE S.E. BT. SCRIBED 1/4 BT  
THE NW BT. HAS ROTTED CENTER  
UNREPAIRING VISIBLE

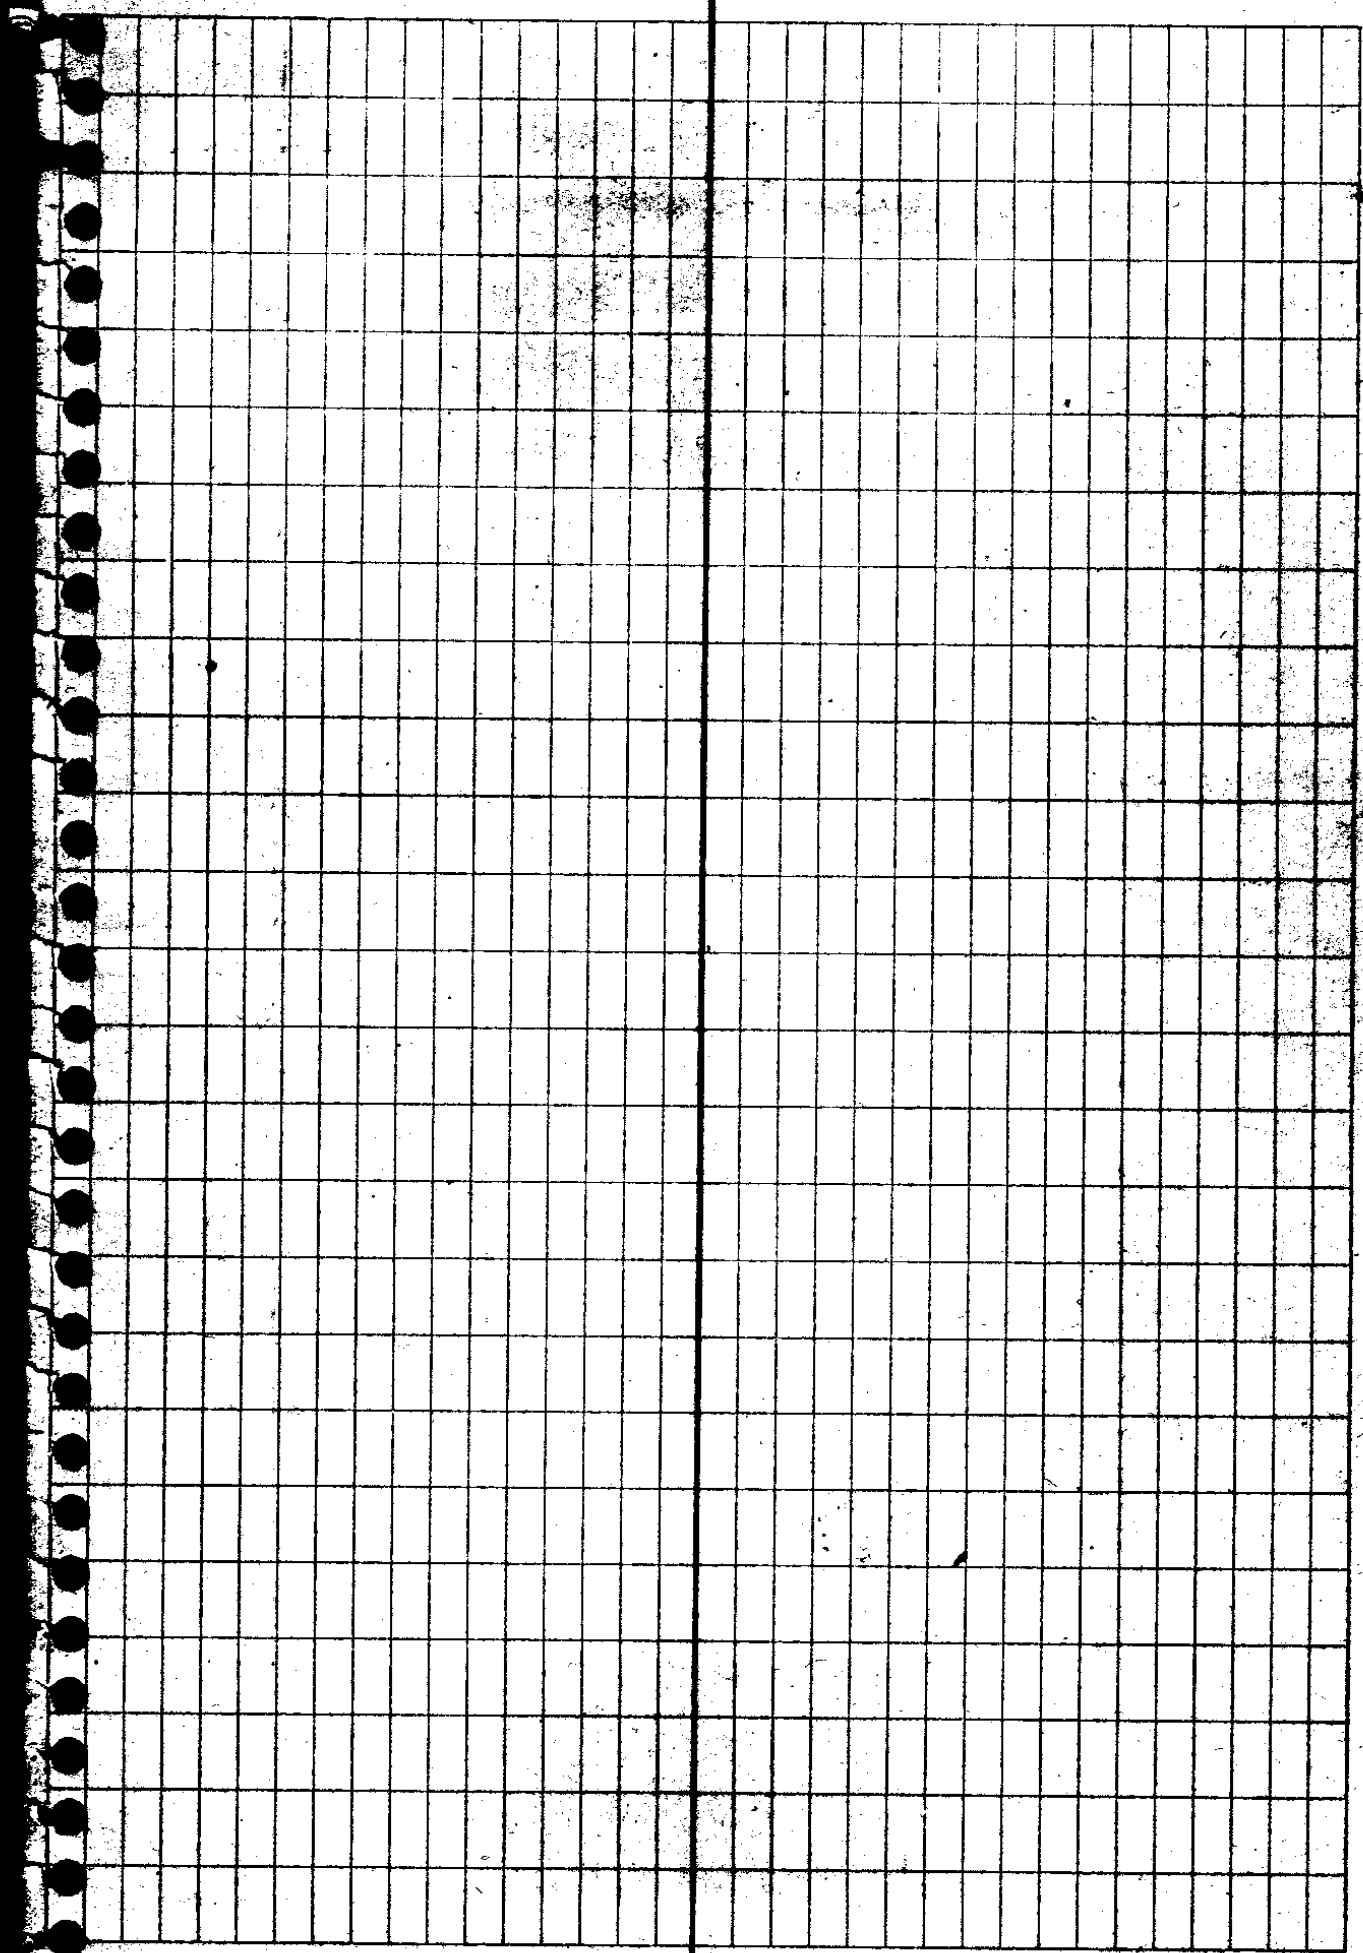

T295 T295  
R6W R5W

NOV. 23-59

~~RENEW~~ 13/18

J. BYRON

R. IRVING

J. FEE

FOUND - ORIG. N.E. BT. NOW DOWN

& ROTTED, PART OF OLD BLAZE ON

SCRIBING T 29 W VISIBLE.

ORIG. S.E. BT. STANDING CENTER

ROTTED, SHOWS OLD BLAZE.

~~THE~~ NW & SW BTS. GONE.

SET BRASS CAP AT CORNER USING

N.E. BT & S.E. BT. CAP MARKED

T295	T295	COUNTY SURVEYORS OFFICE
R6W12	R5W	
13/18	1954	

VAR. 214°



BLAZED & SCRIBED  
 10" W.O. T 295 R 6 W  
 S 12 AS BT.

BLAZED & SCRIBED  
 14" W.O. T 295 R 6 W  
 S 13 AS BT.

BLAZED & SCRIBED  
 10" W.O. T 295 R 5 W  
 S 7 AS BT.

BLAZED & SCRIBED  
 12" W.O. T 295 R 5 W  
 S 18 AS BT.



BRASS CAP

RENEW S.W. COR 18

FOUND -

24" OAK STUMP CENTER (NITE)

ROTTED MAY BE ORIG. BT MEASURES

124° T 1" I. PIPE

15" OAK STUMP N 15° W MAYBE

ORIG. BT CENTER ROTTED CHECKS

RECORD DIST.

48" B.O. TREE STANDING S 85° W

46° MAYBE ORIG.

ORIG. BT. S 85° E 60'

PREVIOUSLY RENEWED (IN RENEWED CONT. DATA)

~~RECORDED~~ (RENEWED BY MARK HAM)

48" B.O. S 85° W 46°

BARK SCRIBED S 24 BT

48" B.O. N 82° W 76°

SCRIBED S 13 BT

48" B.O. NORTH 74°

BARK SCRIBED S 18

24" W.O. S 15° E 134°

SCRIBED S 19 BT