

1/4 Corner Common to Secs. 2 & 11
T. 27 S. - R. 3 W.

Set 2 new witness trees
as follows

12" Fir N. 35° E 86.7


14" Cedar S. 89° E. 64.5

~~3~~ 4" I. Pin Still in place

3-3-55 - F. C. Freear
Wm Paulsen

Garrett
Skelton et al

Acct. Road
Construction
Rd # 17

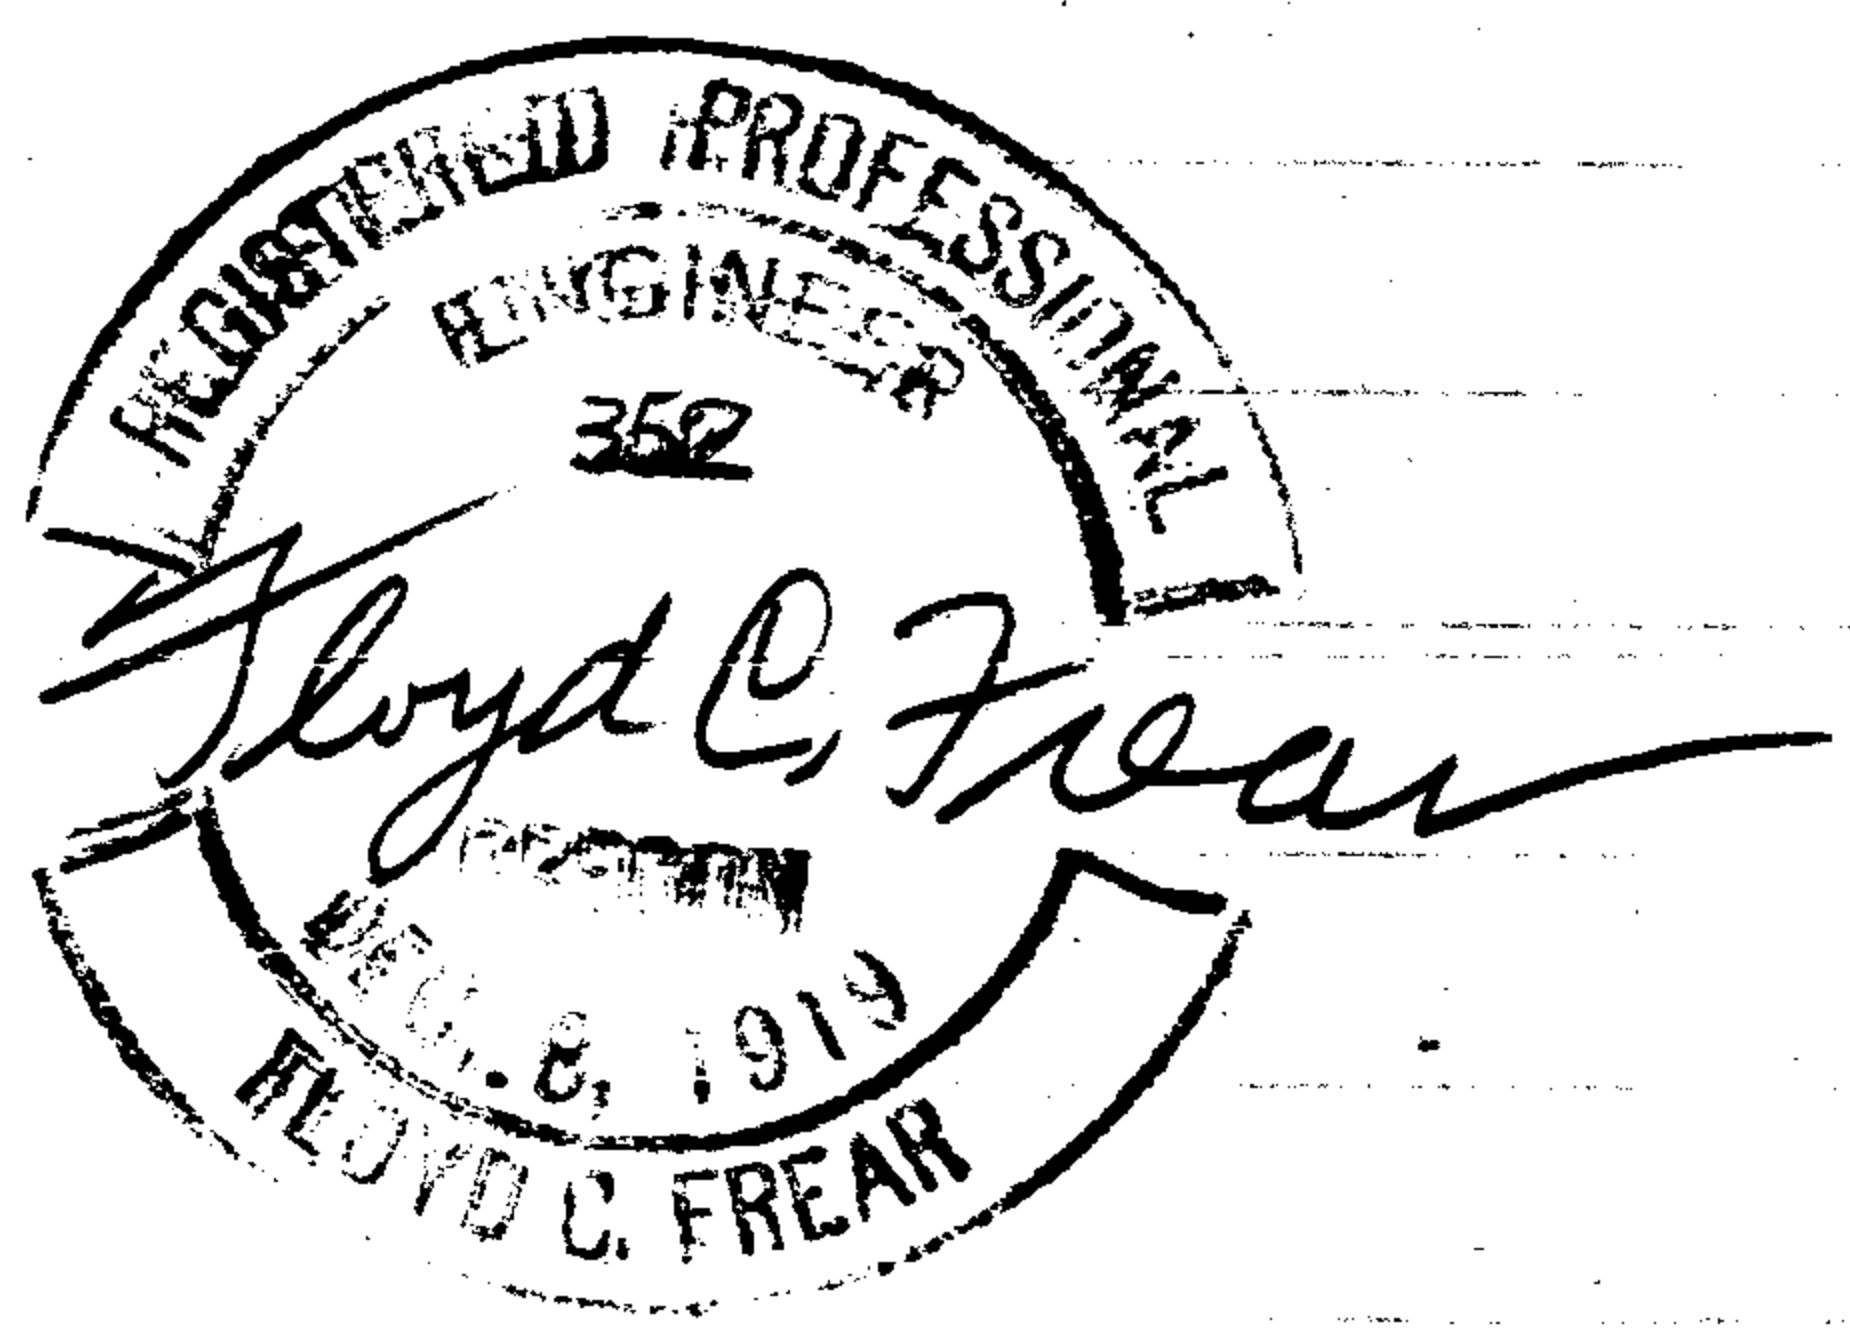

C. S. File No. 16/86

Cov 2-11

T. 27-3 - Be Cut

12" Fir N. 35 E 86.7 - N 34 E

14" Cedar S. 89 E 64.5 S 85 E

10" W.O. S. 84 W - 1190
NEW TREE

May 23-55

7 near
vertical
Dale Dietzgen

~~Dale Dietzgen~~

DIETZGEN NO. 386-B

C. S. File No. 46/86