


### SECTION 2 T. 33 S., R. 5 W. W.M.

*Geo. J. Wenderoth*

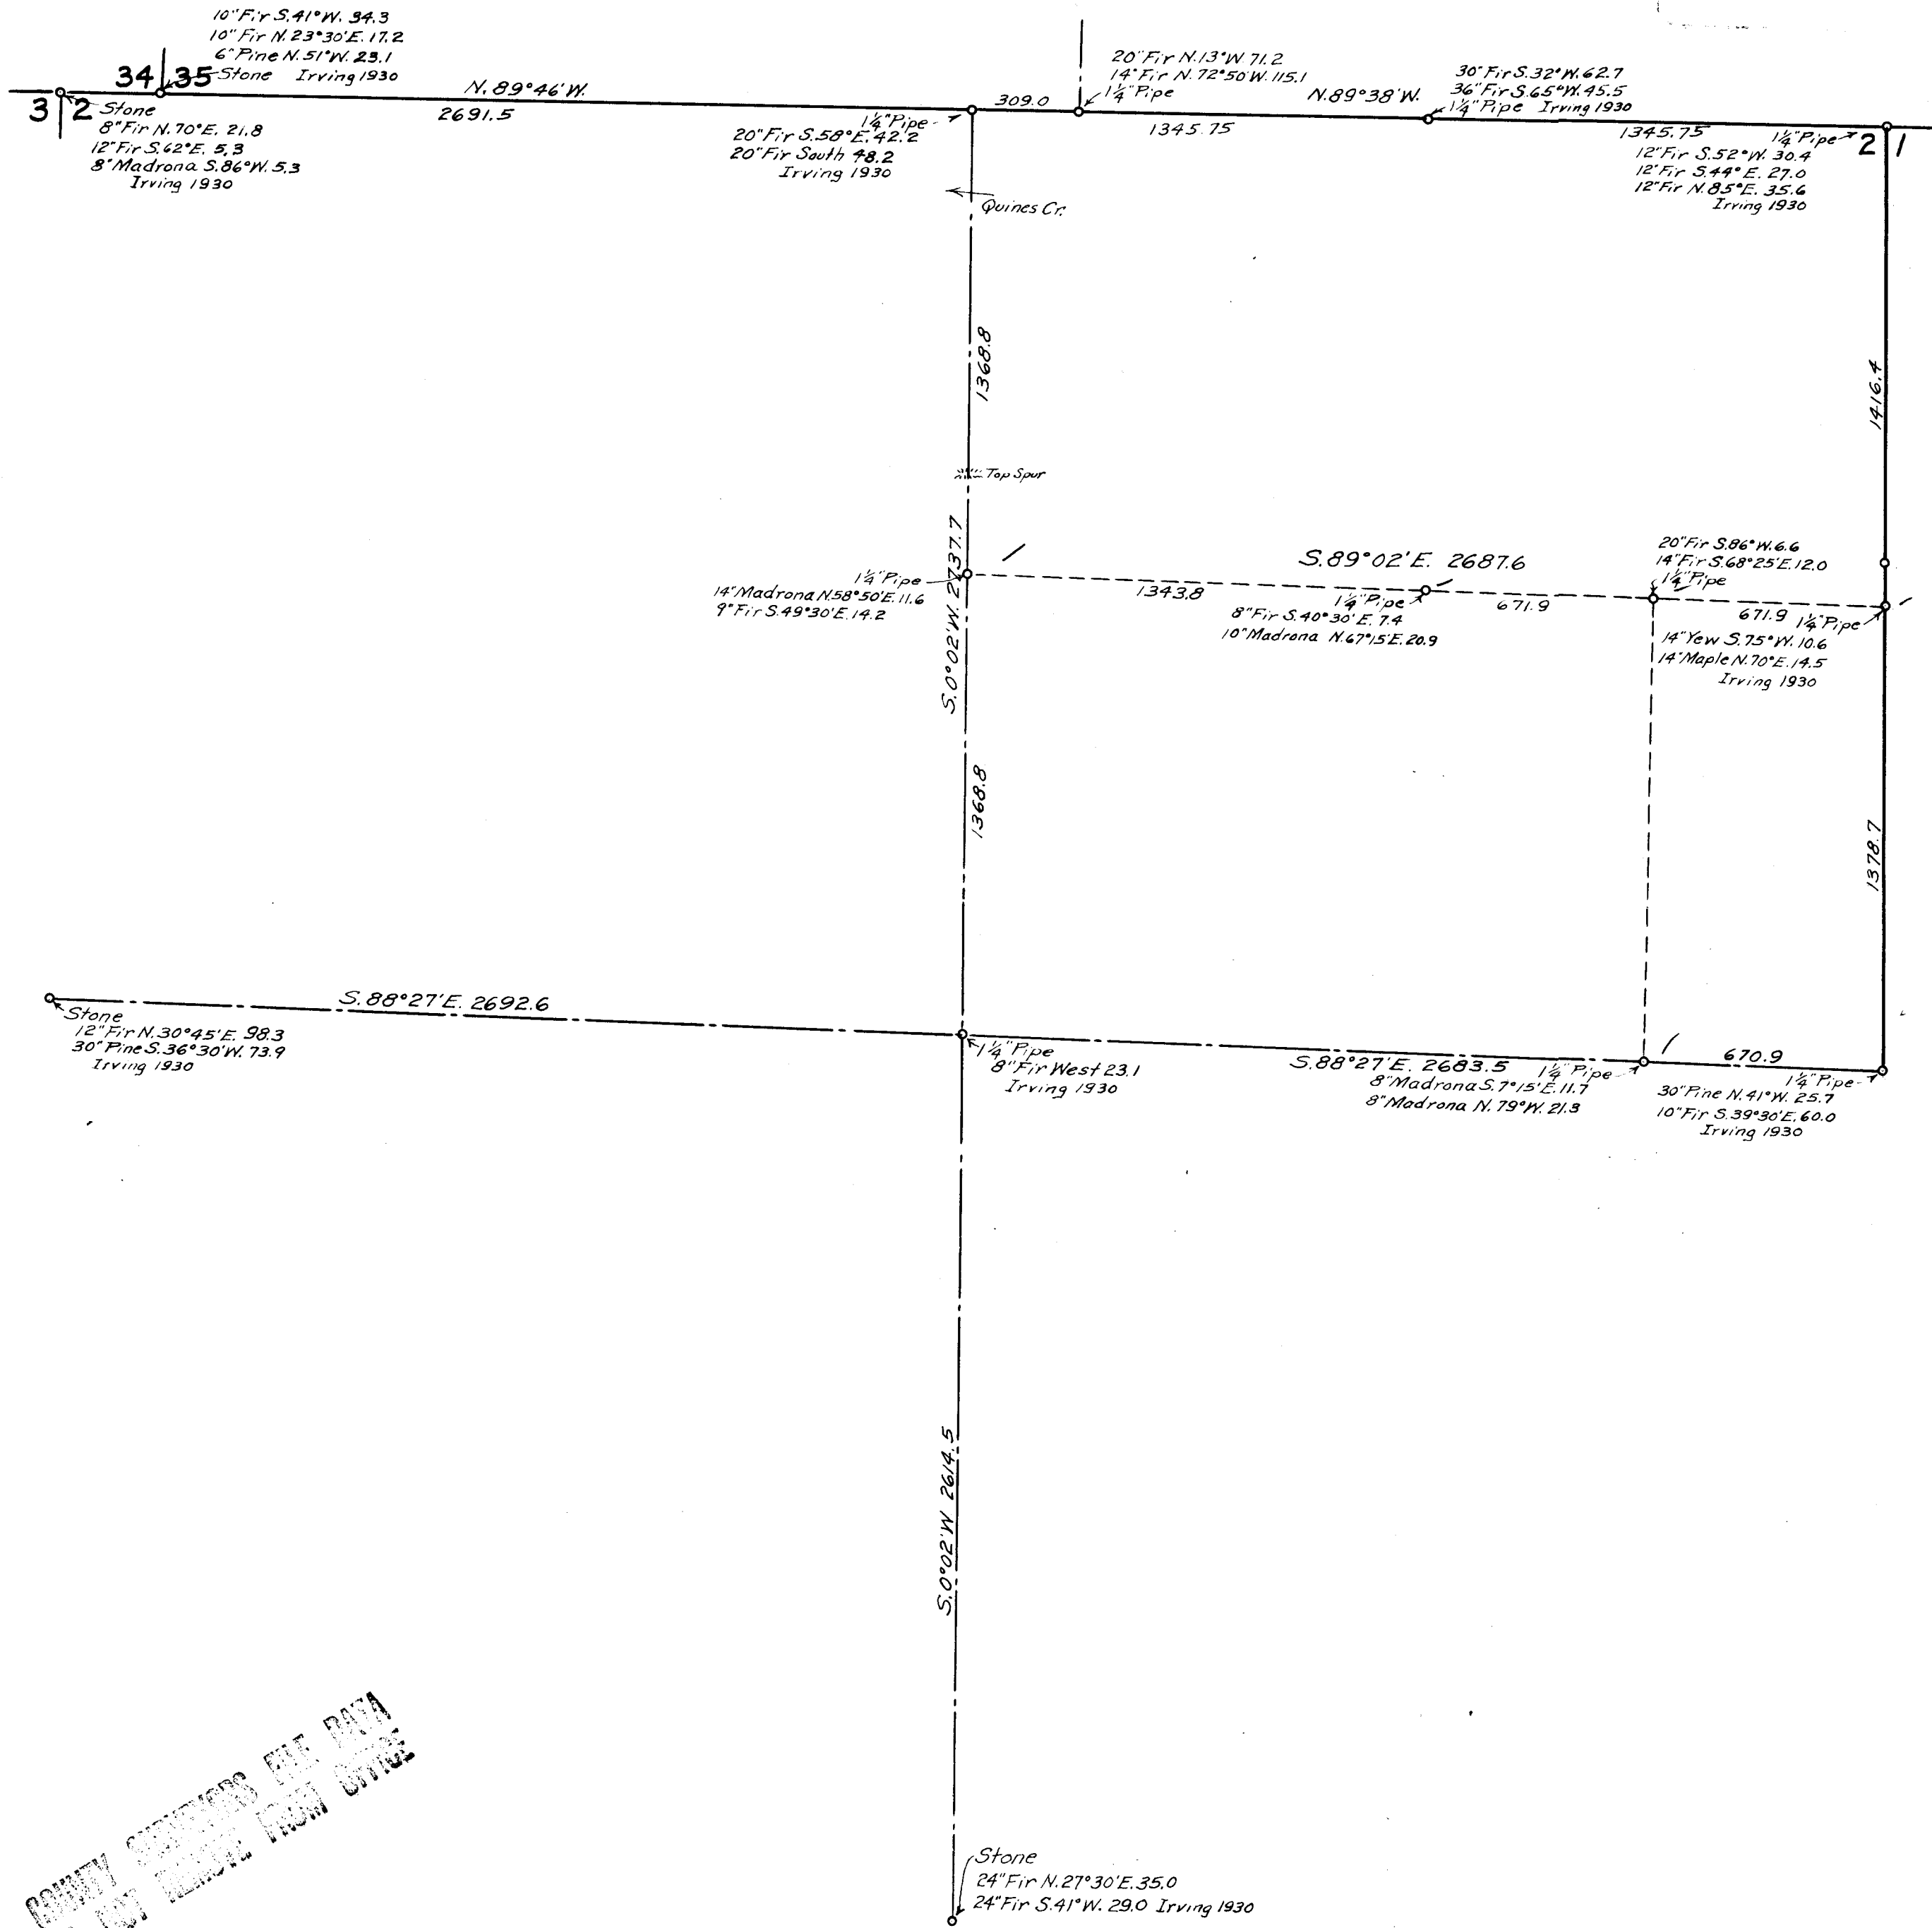

COUNTY RECORDERS FILE DATA  
DO NOT REMOVE FROM OFFICE