

FOUND 1 1/2" AXLE 1' ABOVE GROUND  
 4 1/2" PINE BEARS 5 1/2" x 15 1/2" KNIFE  
 SCRIBED 31 B.T. 4 1/2" PINE BEARS  
 3 6 1/2" x 3 3/8" KNIFE SCRIBED 30 BT  
 BOTTOM OF OLD PINE STUMP  
 35 5/8" x 3 7/8" & BOTTOM OF OLD PINE  
 STUMP N 20° E S. 9' (BOTH TREES  
 CHECK FOR ORIGINAL B.T.S.)  
 BLAZED & SCRIBED 6" PINE N 12° W S.S.  
 N 13° W S 25' C.S. BT. UNKAZED & SCRIBED  
 6" PINE S 47° W AT 4' N 13° W 3 3/8" C.S. BT.  
 BLAZED & SCRIBED 7" PINE S 8° 30' E  
 2 6 1/2" N 12° W S.S. C.S. BT. BLAZED &  
 SCRIBED 7" PINE N 31° E 2 3/8" N 12° W  
 5 30" C.S. BT.

BLAZED & SCRIBED 4 1/2" SPHULE C.S. BT. S 61° E 1 1/2'  
 "S-T 3/4" IRON ROD EAST 1034.10'


SET 3/4" IRON PIPE  
 BLAZED & SCRIBED 1 1/2" YELLOW PINE S 38° E  
 1 6 1/2" C.S. BT.

25 30  
 36 31

366.04'

122.68'

543.38'

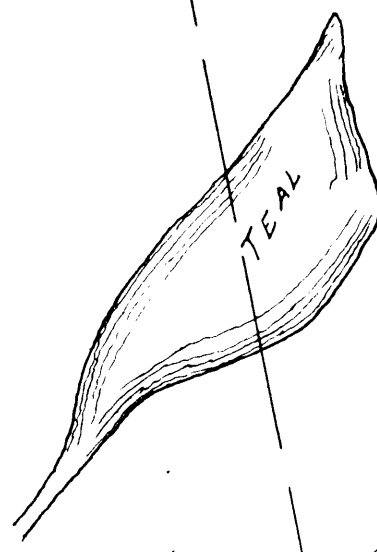

COAST HIGHWAY

U S 101

N 11° 42' 20" W  
 1119.22' 20" W

FOUND IRON ROD

12.23 Ac

393 + 15.16 PS

120'

N 11° 42' 20" W  
 1119.22' 20" W

924.0'

924.0'

SET 1" IRON PIPE  
 BLAZED & SCRIBED 20" FIR  
 S 47° 45' E 19.37' C.S. BT.

WEST 1034.10'

SET 3/4" IRON PIPE

489.64'

SET 3/4" IRON ROD  
 12 1/2' SOUTH OF CORNER  
 BLAZED & SCRIBED 1 1/2" CEDAR  
 N 10° E 1 6 1/4" C.S. BT.

NOTE -  
 BASES OF BEARING N 11° 42' 20" W  
 FROM HIGHWAY SURVEY  
 0° 32' 50" W, USED AS CORRECTION  
 FROM MAG TO TRUE BEARING



COUNTY SURVEYOR'S OFFICE  
 DOUGLAS COUNTY, OREGON

SURVEY FOR DEED DESCRIPTION,  
 SECTION 31, T22S, R12W, W.M.

BEN B. IRVING COUNTY SURVEYOR  
 SURVEYED MAR. 3, 1955 BY  
 JAMES W. BYRON - DEPUTY SCALE 1" = 100'  
 SURVEYED FOR A. WEST

FOUND 3/4" x 10" IRON PIPE AT 3' x 3"  
 59 POST SCRIBED 1/4 COR. ON NORTH  
 FACE, 31 ON EAST FACE, 36 ON  
 WEST FACE & DL ON SOUTH FACE

REGISTERED  
 OREGON  
 LAND SURVEYOR

James W. Byron  
 NOV. 6, 1955  
 JAMES W. BYRON  
 303