


O. Worley 1951
H.D. Hauck 1955

COUNTY SURVEYOR'S OFFICE
DOUGLAS COUNTY, OREGON.
Surveys in
SECTION 1, T. 32 S., R. 4 W. W.M.

Geo. J. Wendert

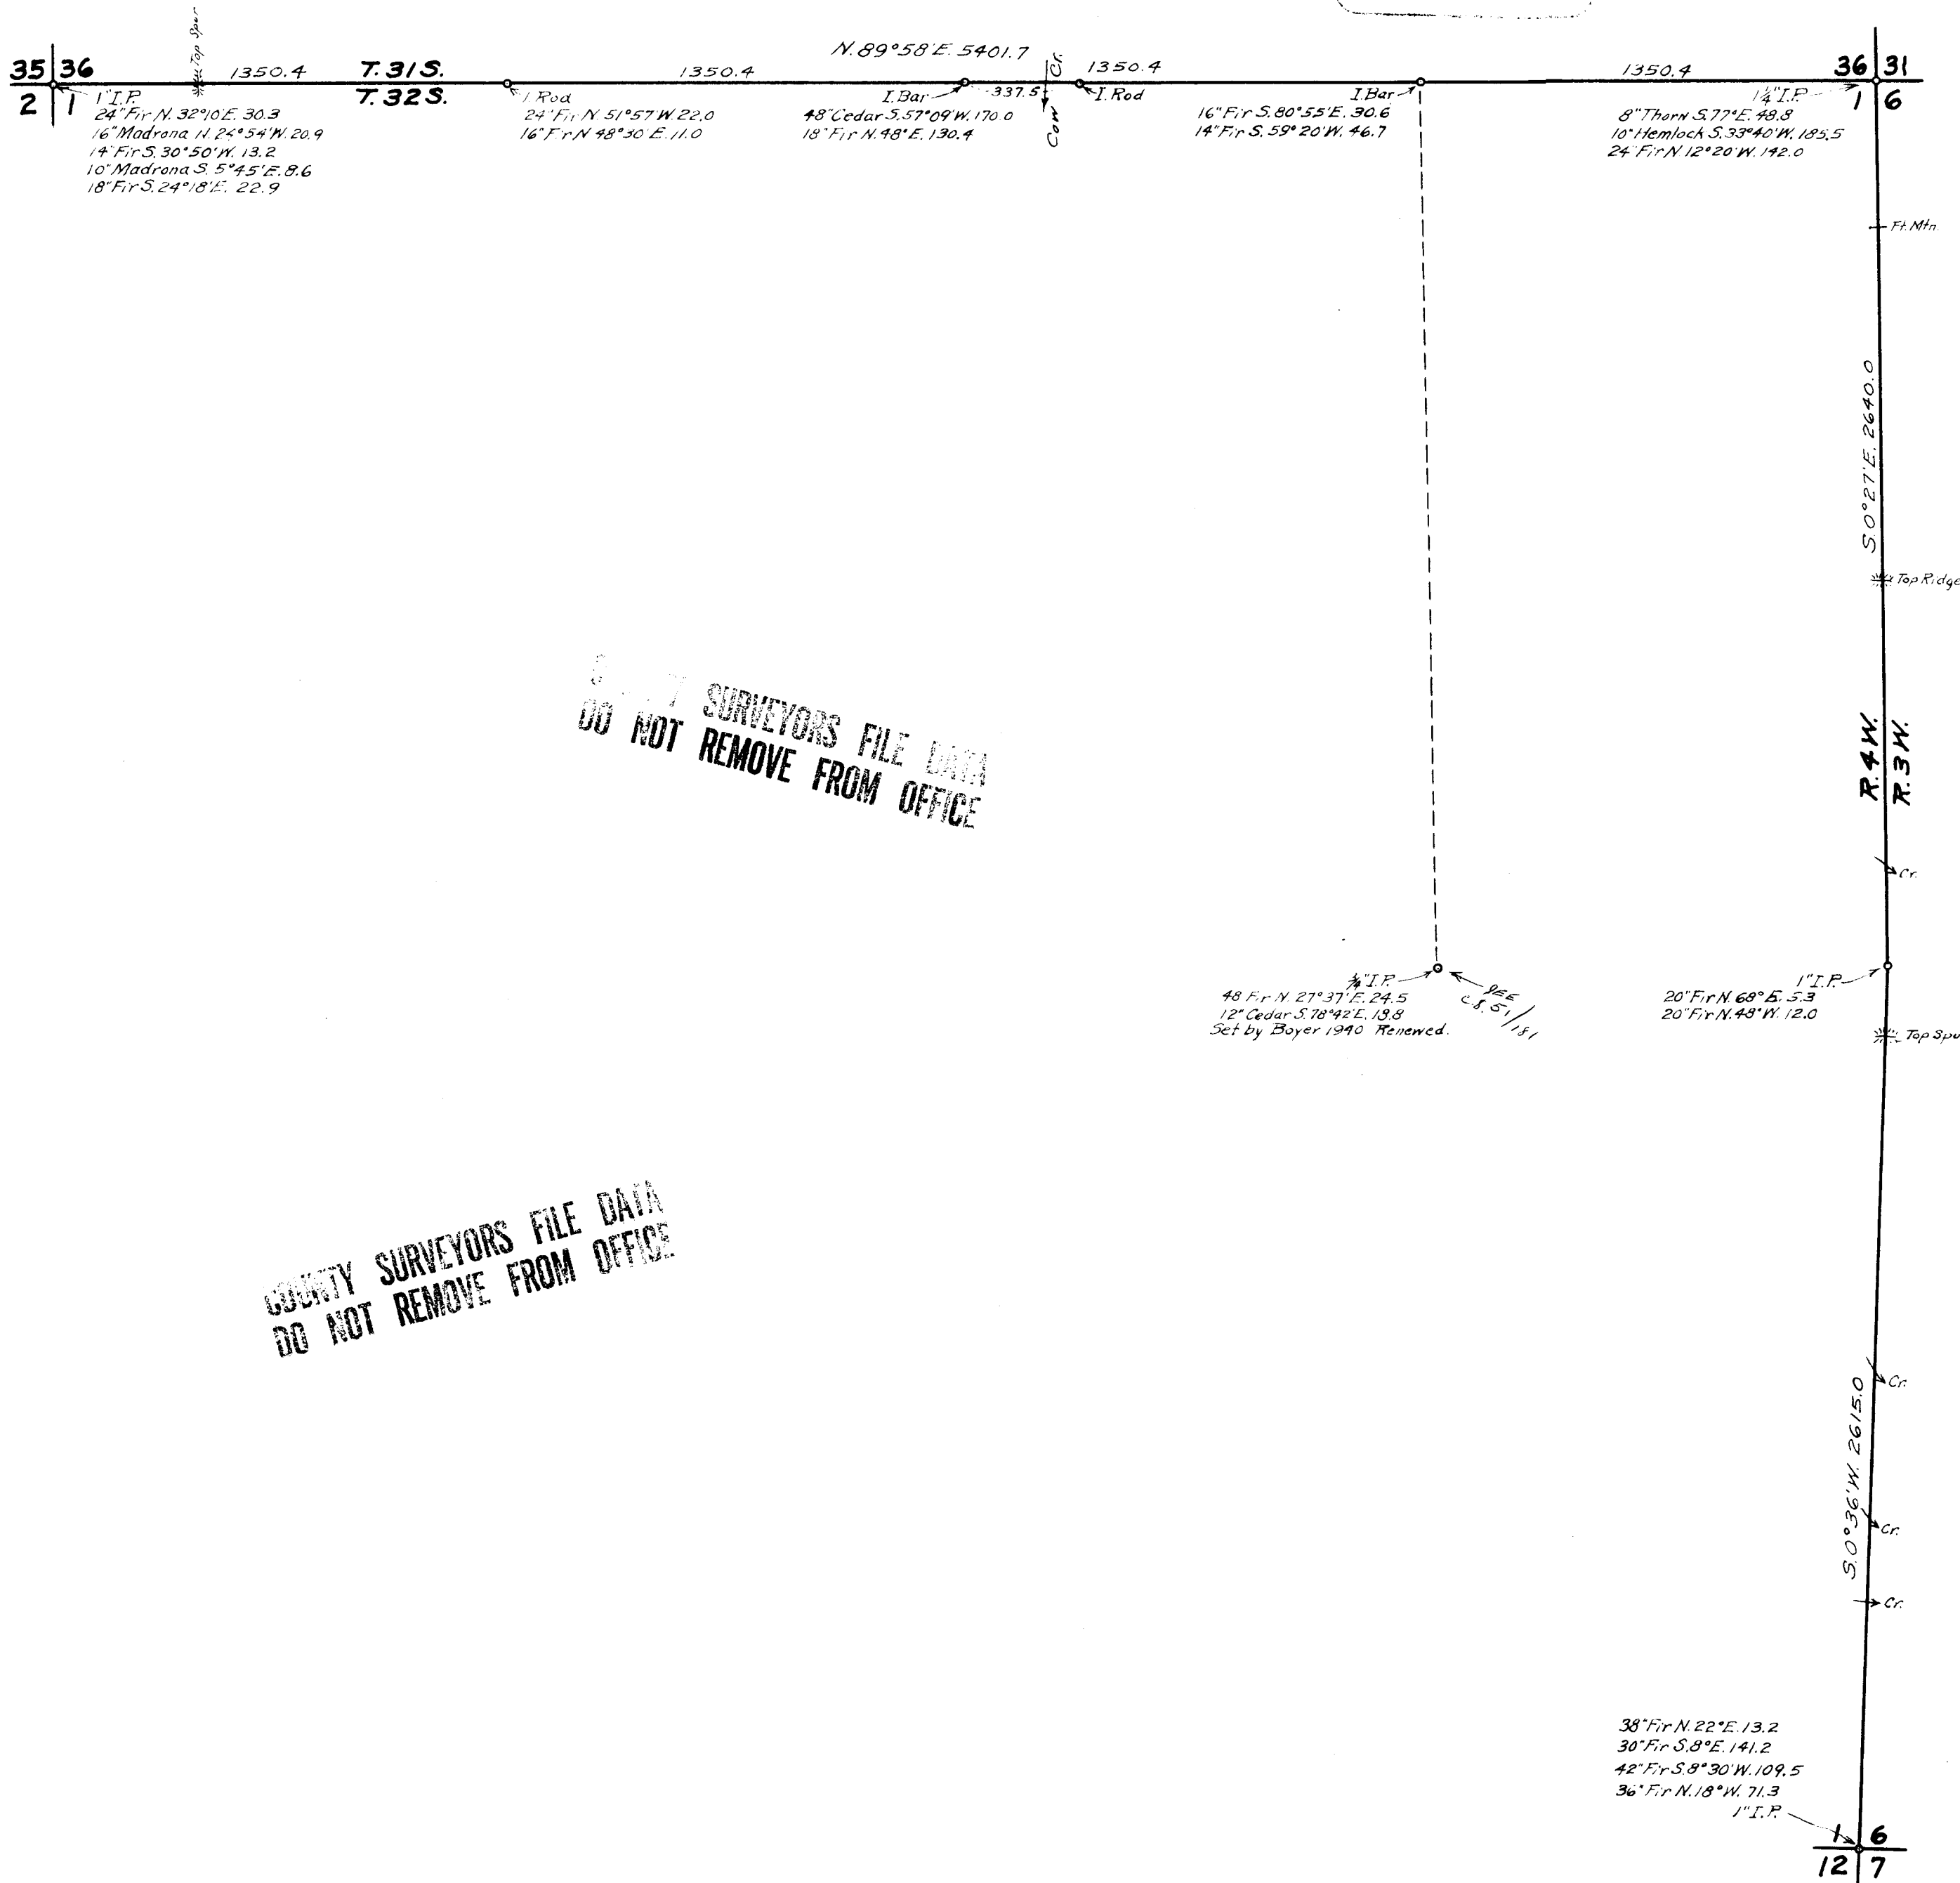

COUNTY SURVEYORS FILE DATA
DO NOT REMOVE FROM OFFICE

COUNTY SURVEYORS FILE DATA
DO NOT REMOVE FROM OFFICE