

Renewal of Corners in
T 25 S, R 5 W.

$\frac{20}{29} \frac{21}{28}$ 29 | 28

DIETZGEN NO. 385-6

C. S. File No. 46/150

RENEW $\frac{1}{4}$ COR. 29/28

T 255 R 5W

FOUND STUMP OF W.O.

FACE ROTTED CHECKS RECORD DIST.

$\frac{1}{2}$ BEARING TO 8" X 8" STONE WITH

CROSS UNDER N.S. FENCE, ALSO

FD. SCRIBE MARKS ON SET AT STONE

PROBABLY FROM W.O. STUMP. THE S.W.

BT BONE.

SET 1" X 36" PIPE WITH BRASS CAP

MKD. $\frac{1}{4}$ COR. 29/28 T 255 S R 5W

COUNTY SURVEYORS OFFICE 1955.

BLAZED & SCRIBED 14" R. FIR

N $8\frac{1}{2}^{\circ}$ E 567' S 28 $\frac{1}{4}$ COR. C.S. BT.

BLAZED & SCRIBED 14" R. FIR. 46.3'

N 64° W S 29 $\frac{1}{4}$ COR. C.S. BT.

VAR $2\frac{1}{4}^{\circ}$

RENEW $\frac{2021}{2928}$ | 255 R5W

FOUND 4 1/2" R.F.I.R. S 47° E 66.0
DESCRIBED (BARK) CS BT, FOUND BOTH
S.O. AS RECORDED BY COLLETT AND
THE BOARDS SHOW OLD BLAZES BUT
FACES ARE ROTTEN NO DESCRIBING
VISIBLE. ALL THREE B.T.S CHECK FOR
BEARINGS AND DISTANCES. ALSO FOR
1" X 4" PROPERLY DESCRIBED AT FENCE COR.


SET 1" X 36" I.P. WITH BRASS CAP
MAY 29 1921 SEC. COR. T 255 R 5W
2928
COUNTY SURVEYORS OFFICE 1955

BLAZED & DESCRIBED 6" R.F.I.R.
N 50° E 11' S 21 CS BT

BLAZED & DESCRIBED 6" R.F.I.R.
N 64° W 13.5' S 20 CS BT

BLAZED & DESCRIBED 7" R.F.I.R.
S 38 1/2° W 40.6' S 29 CS BT

DIETZEN NO. 385-6

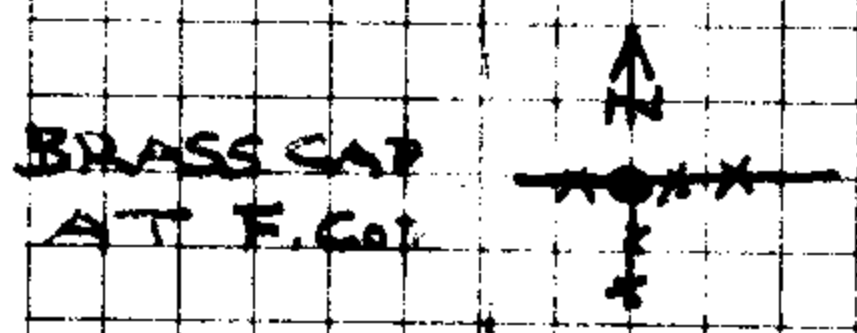

MAY 6 - 1955
H. BYRON
H. BYRON
H. BYRON

VAR. 2 1/4°