


Base of bearings - \odot County road No. 107
 $N 89^{\circ} 55' E$ Survey File 39-26 this office.
 All angles turned & doubled.

Survey made for Division
 by E.S. Woodford
 Surveyors File 40, 40

Survey File 39-26
 County Surveyor's
 Office

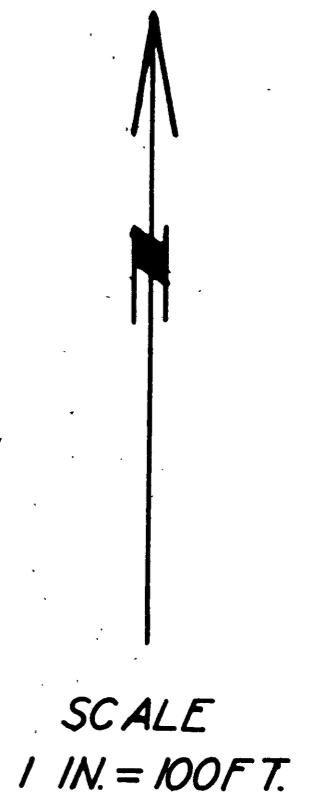

COUNTY SURVEYORS OFFICE
 DOUGLAS COUNTY OREGON
 DIVISION OF THE KIRBY MASTERS PROPERTY
 SEC. 22 T28S, R6W, WM.
 BEN. B. IRVING COUNTY SURVEYOR
 APRIL 1954

