

Lester Oil Co.

Center main track S.P. RR


E. R/W line 2 S.P. N 20° 30' W

River side

This line previously set for Ascor. Oil Co.

Cross of Cont. Pave for

N. 11th Hunt 704 D.L.C. St. Pave west side of R/W

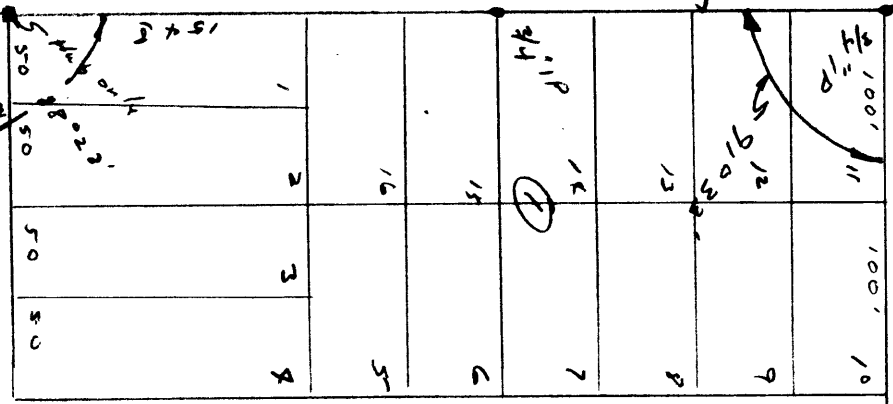

Cedar St.

