


**COUNTY SURVEYORS FILE DATA
DO NOT REMOVE FROM OFFICE**

PACIFIC AVENUE

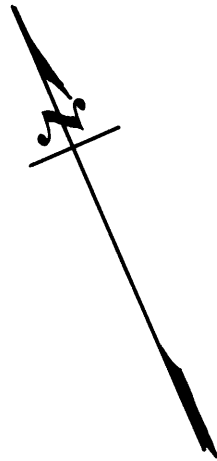

REGISTERED
OREGON
LAND SURVEYOR

Geo. J. Wenderoth


MARCH 10, 1944
George J. Wenderoth
5

**COUNTY SURVEYORS OFFICE
DOUGLAS COUNTY, OREGON.**


SURVEY FOR
HAROLD DAVIDSON
LOT 8, BLOCK 5, CITY OF GLENDALE
GEO. J. WENDEROTH, DEPUTY. SEPT. 1955
SCALE 1" = 100ft.

13

ST.

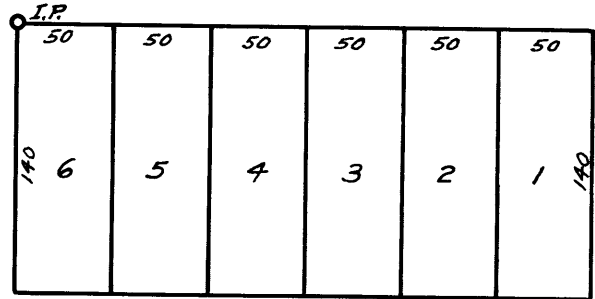


ST.

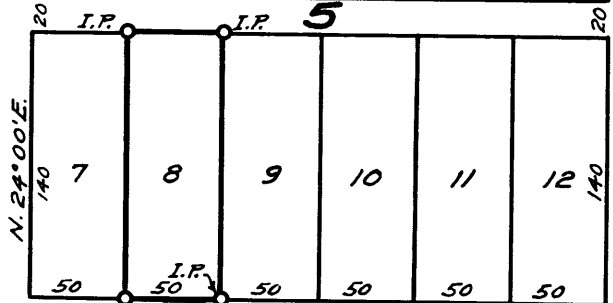

5TH

WILLIS AVENUE

6TH

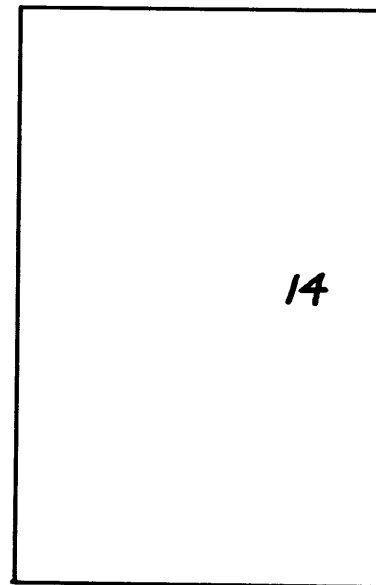

14

MONTGOMERY AVENUE

AVENUE

25

7TH

24

23

C. S. File No. 46/174