

**COUNTY SURVEYORS FILE DATA  
DO NOT REMOVE FROM OFFICE**

FILED  
RECEIVED

DEC 3 1955

COUNTY SURVEYOR  
DOUGLAS COUNTY, ORE.

C. S. File No. 47/24

**COUNTY SURVEYOR'S OFFICE  
DOUGLAS COUNTY, OREGON.**

**SURVEY FOR  
Howard Burke  
SEC. 32, T. 32 S., R. 6 W., W. M.  
Geo. J. WENDEROTH, Deputy. Nov. 1955  
Scale - 1" = 100ft.**

REGISTERED  
**OREGON**  
LAND SURVEYOR

*Geo. J. Wenderoth*

MARCH 10, 1944  
George J. Wenderoth  
5

Survey Notes for Howard Burke Survey.  
Section 32, T.32S.,R.6W.

Begin at Quarter Corner between Sections 32 and 33 which is a 1½ inch iron pipe, find both bearing points as follows.

Ledge rock N.45°W. 11.2 feet. X and C.S. cut in rock.

Ledge rock N.21°30'E. 40.8 feet. X cut in rock.

Run west along center line of Section 32.

At 572.7 feet find a iron bolt on line as N.E. Corner of Tract 2.

At 694.5 feet find a 1" iron pipe on line as N.E. Corner of tract 1.

At 859.5 feet find a ¾" iron pipe on line as N.W. Corner of tract 1.

Find a ¾" iron pipe which is the S.E. Corner of Tract 2 and on the North line of the County Road.


Find that the bearing between the Corners found for the North and South lines are S.0°52'E. instead of S.1°26'E. as shown on the deeds.

Tract No.1 is 165.0 feet wide between Corners found.


Tract No.2 is 111.8 feet wide between Corners found.

I run these tracts out between the East and West center line of Section 32 and the North line of the County Road as shown on the accompanying map which shows the courses of the County Road and other lines run.

Survey made November 30, 1955.

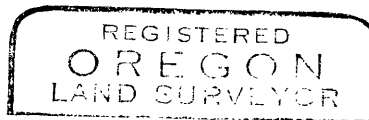

*Geo. J. Wenderoth*

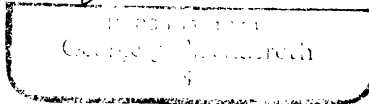

FILED  
RECEIVED

DEC 5 1955

COUNTY SURVEYOR  
DOUGLAS COUNTY, ORE.

C. S. File No. 47/24