


*See Map Revised
9/11/56*

WATER RIGHT
FOR
W. H. DAMEWOOD
SECTION 11, T27S, R3W, W.M.

OFFICE OF
BEN B. IRVING
COUNTY SURVEYOR, DOUGLAS COUNTY
ROSEBURG, OREGON

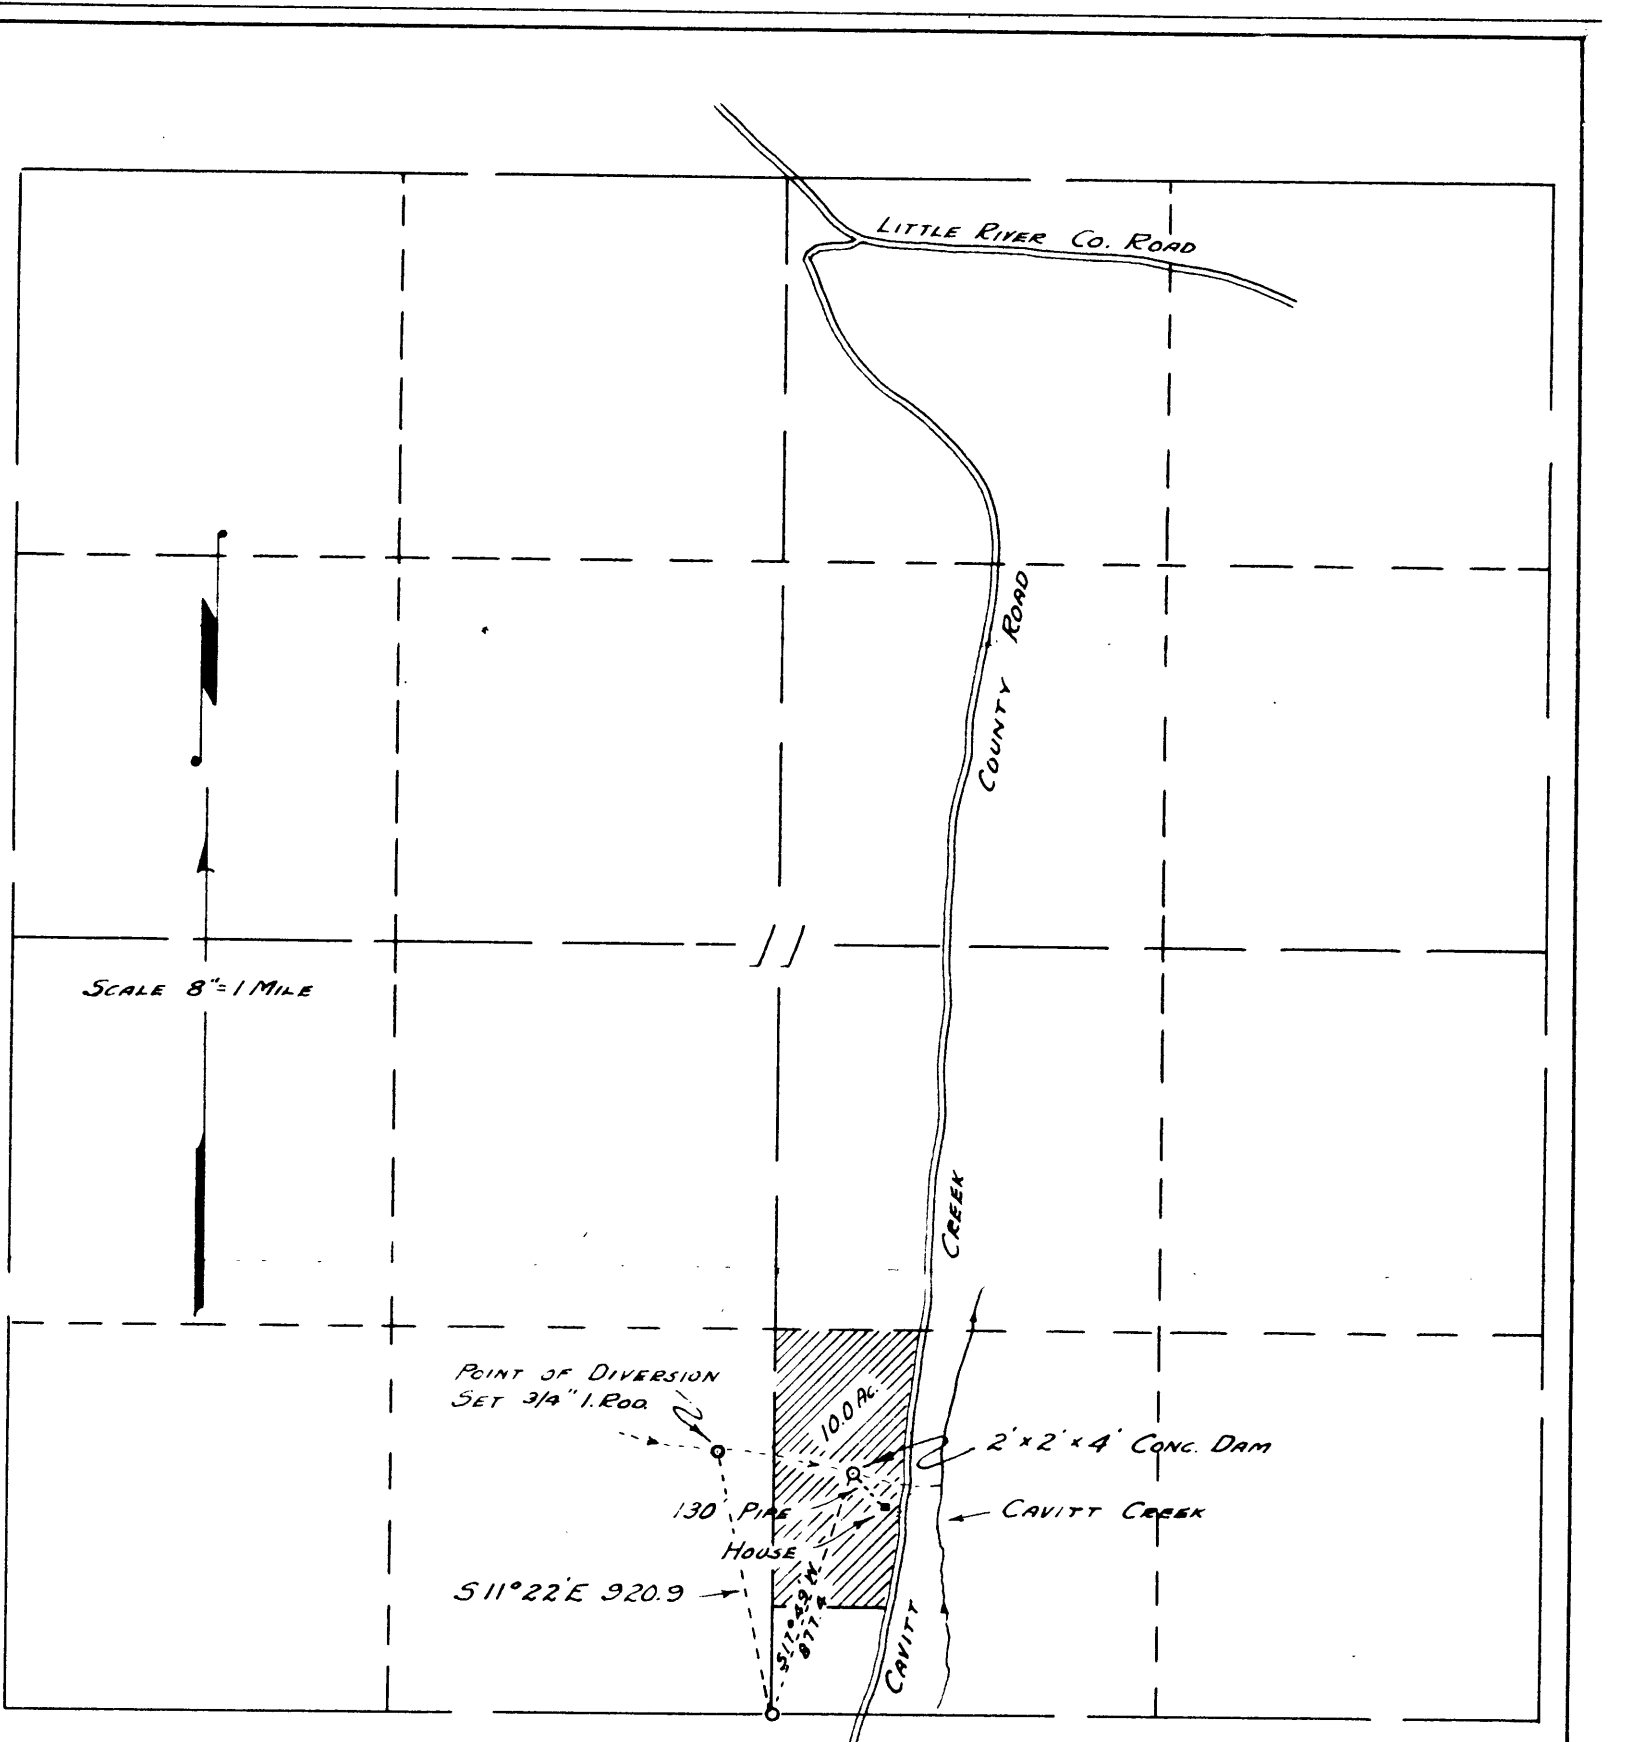

**WATER RIGHT
 FOR
 W. H. DAMEWOOD
 SECTION 11, T27S, R3W, W.M.**

OFFICE OF
 BEN B. IRVING
 COUNTY SURVEYOR, DOUGLAS COUNTY
 ROSEBURG, OREGON

JAMES W. BYRON STATES HE IS BY OCCUPATION A REGISTERED LAND SURVEYOR EMPLOYED BY W. H. DAMEWOOD, TO MAKE THE SURVEY OF THE RIGHT OF WAY AS DESCRIBED AND SHOWN ON THIS MAP; THAT THE SURVEY OF SAID WORKS WAS MADE BY HIM AND UNDER AUTHORITY, COMMENCING ON THE 5TH DAY OF AUGUST 1955, AND ENDING ON THE 5TH DAY OF AUGUST 1955; AND THAT SUCH SURVEY IS ACCURATELY REPRESENTED UPON THIS MAP.


James W. Byron
James W. Byron

THIS IS TO CERTIFY THAT JAMES W. BYRON, WHO SUBSCRIBED THE STATEMENT HEREON IS THE PERSON EMPLOYED BY THE UNSIGNED APPLICANT TO PREPARE THIS MAP, WHICH HAS BEEN ADOPTED BY THE APPLICANT AS THE APPROXIMATE FINAL LOCATION OF THE WORKS THEREBY SHOWN; AND THAT THIS MAP IS FILED AS A PART OF THE COMPLETE APPLICATION AND IN ORDER THAT THE APPLICANT MAY OBTAIN THE BENEFITS OF STATUTE AND I FURTHER CERTIFY THAT THE RIGHT - OF - WAY HEREIN DESCRIBED IS DESIRED FOR WATER.

W. H. Damewood
 W. H. DAMEWOOD

RIGHT - OF - WAY
 FOR
 W. H. DAMEWOOD
 SECTION 11, T27S, R3W, W.M.

OFFICE OF
 FRED M. DARBY
 COUNTY SURVEYOR, DOUGLAS COUNTY
 ROSEBURG, OREGON

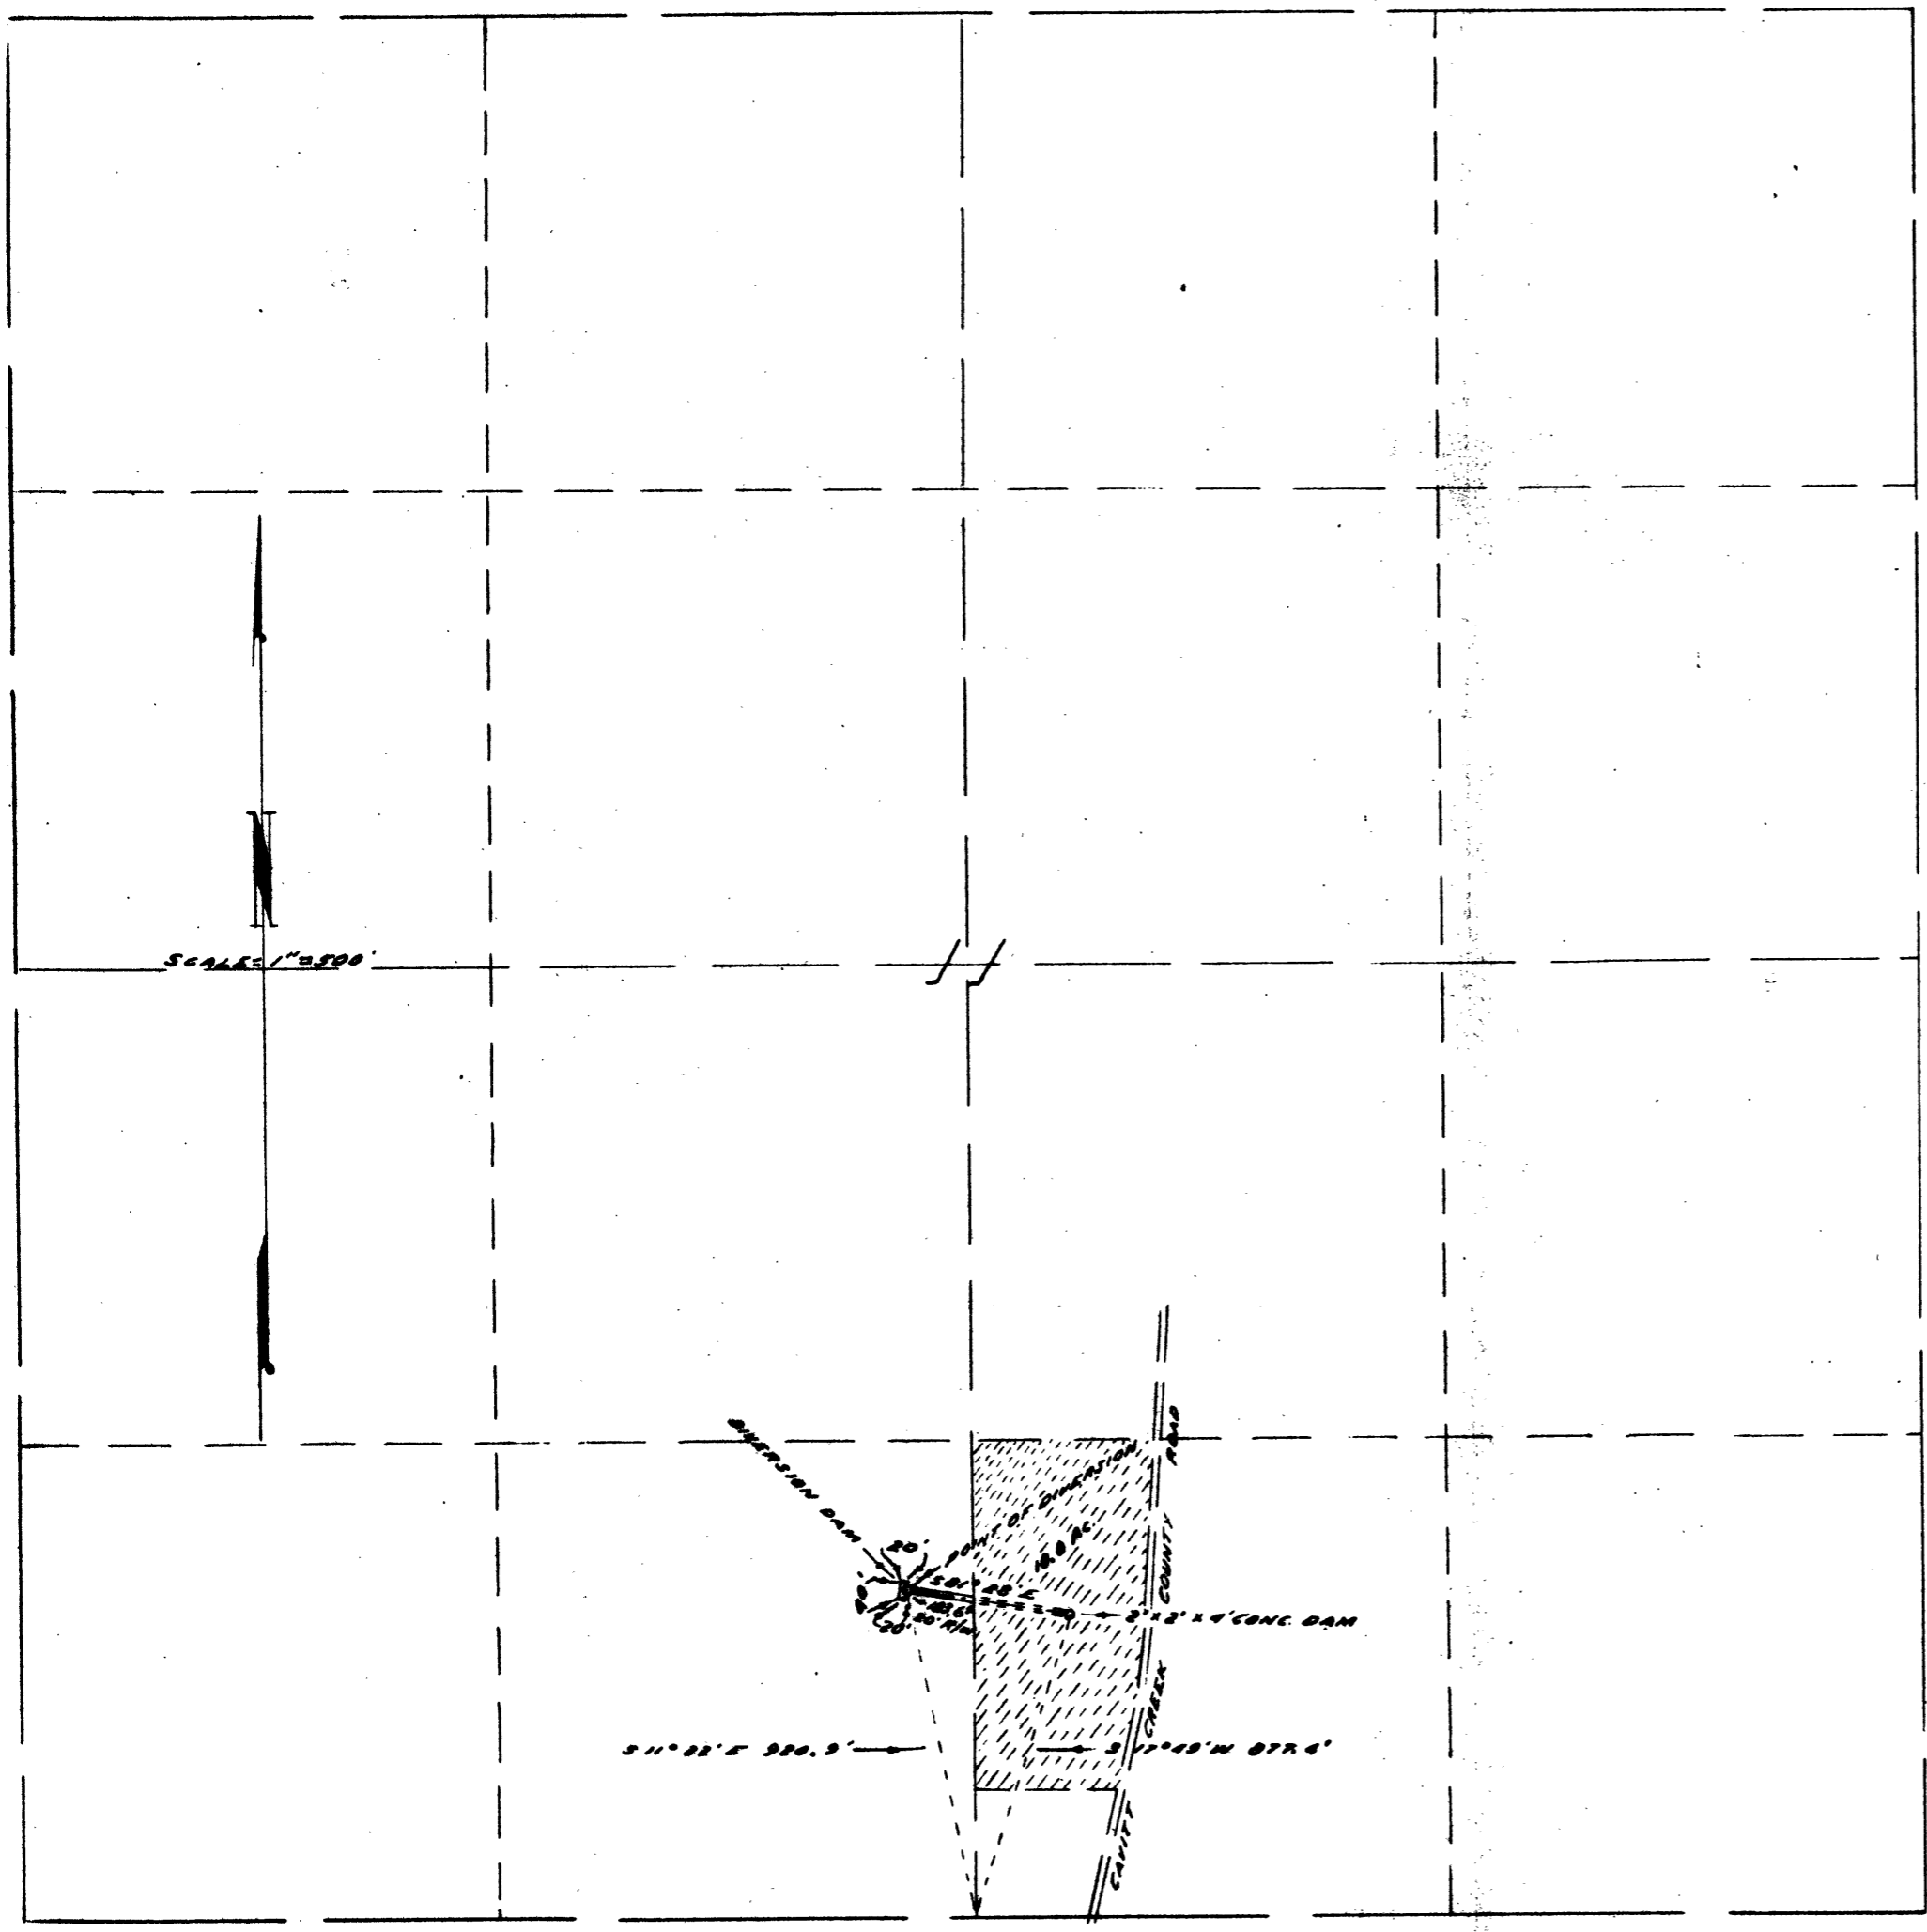

CS FILE FOLDER

CONTAINS

MORE

INFORMATION