
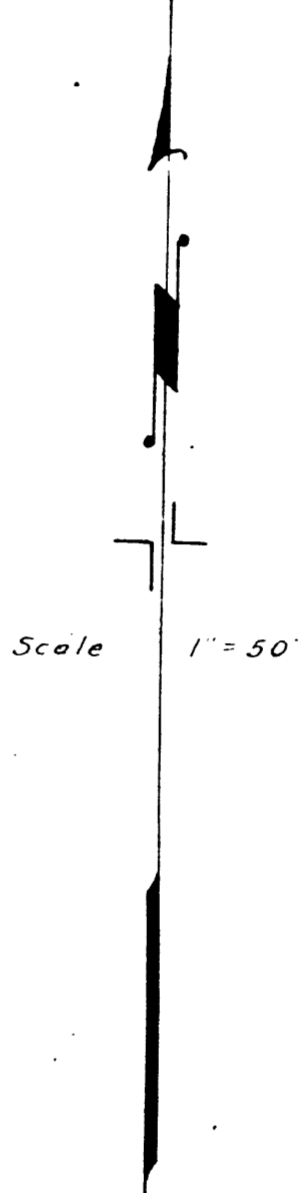


Fd. I.P. & Brass Cap m'kd Co.  
Surveyors Office -S. 8, 9, 16, 17  
& Bearing trees

8 9  
17 16

T 22 S., R 5 W.  
W.M.

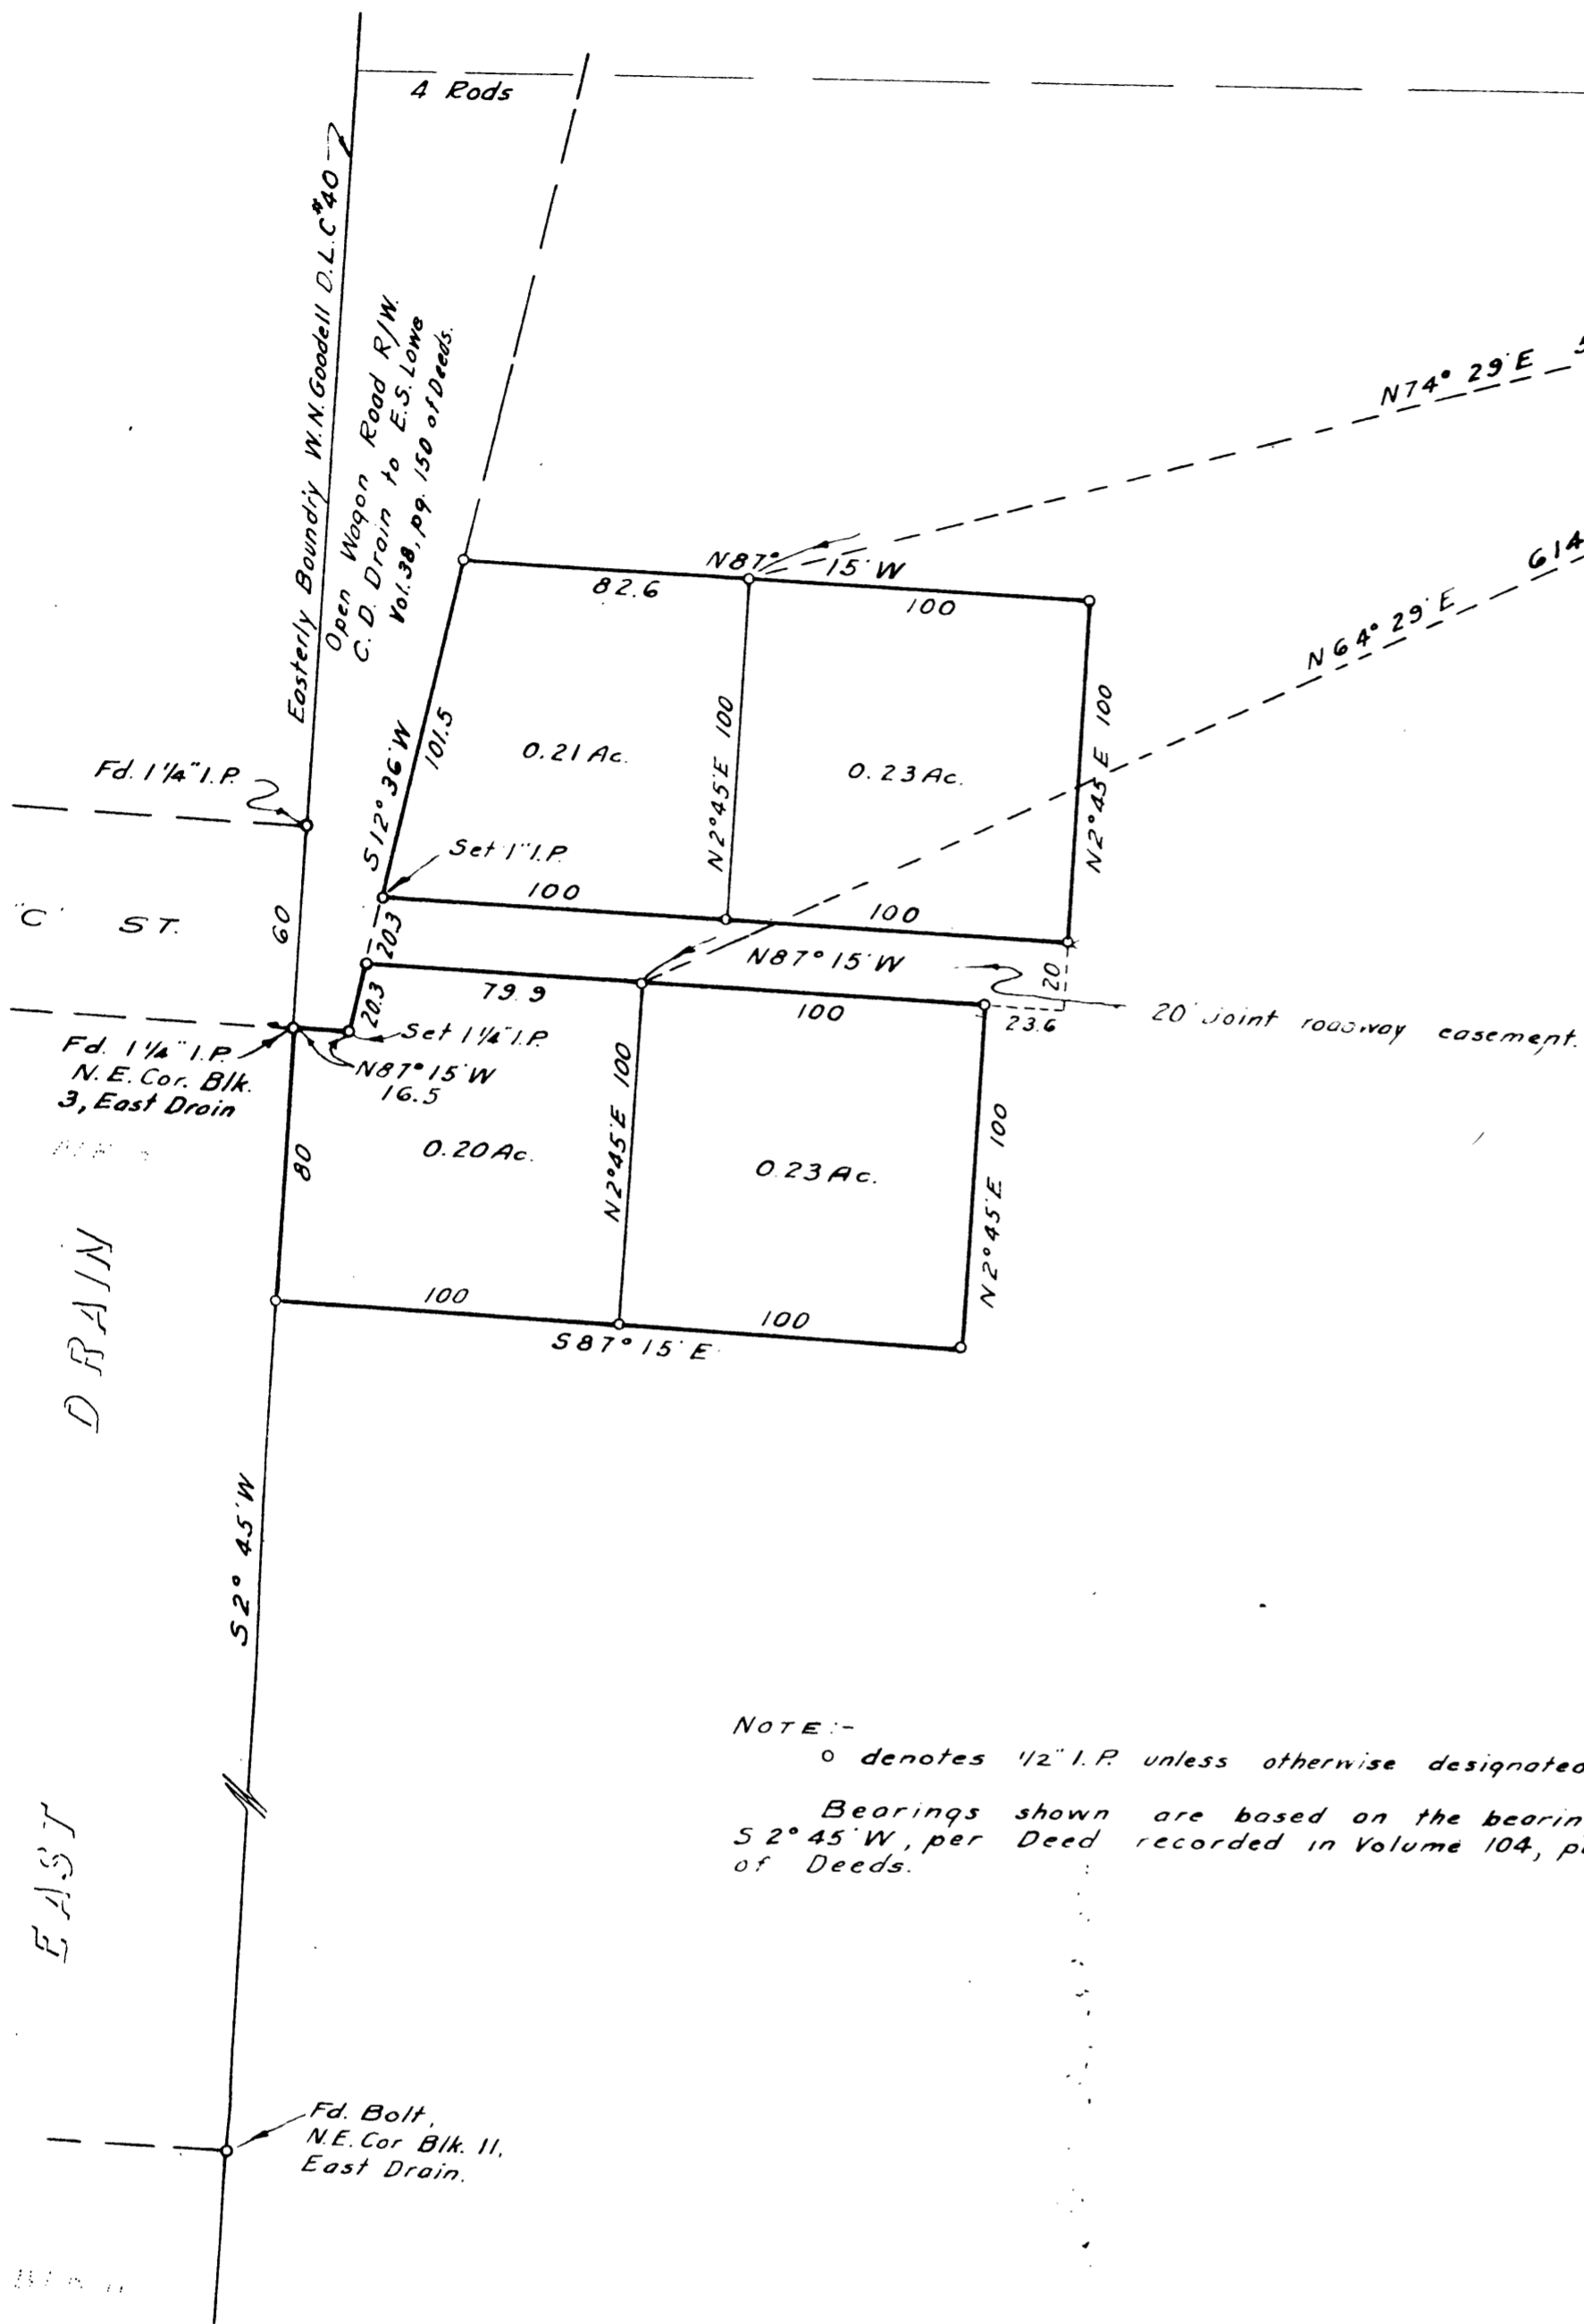

NOTE:-  
 o denotes 1/2" I.P. unless otherwise designated.  
 Bearings shown are based on the bearing of  
 S 2° 45' W, per Deed recorded in Volume 104, page 633  
 of Deeds.

COUNTY SURVEYOR'S OFFICE  
 DOUGLAS COUNTY, OREGON

SURVEY FOR DEED DESCRIPTION  
 SECTION 17, T 22 S., R 5 W., W.M.

BEN. B. IRVING  
 SURVEYED JULY 30, 1948.  
 N.E. RICHARDSON

COUNTY SURVEYOR  
 BY  
 DEPUTY

*N.E. Richardson*

N 1/2 R E



7.1  
10.1  
10.4  
10.8  
11.1  
11.4  
July 6, 1940.

SCALE 1" = 200'  
100

PLAT OF  
LOVELACE AND ADJOINING  
DEEDS  
T 22 S, R 5 W, WM. - DRAIN  
DOUGLAS COUNTY OREGON  
BEN. B. IRVING  
County Surveyor

CS FILE FOLDER

CONTAINS

MORE

INFORMATION